


DATE _____

TOWN OF LEXINGTON — BOARD OF PUBLIC WORKS

SEWER DIVISION

Sketch of Service Here

4

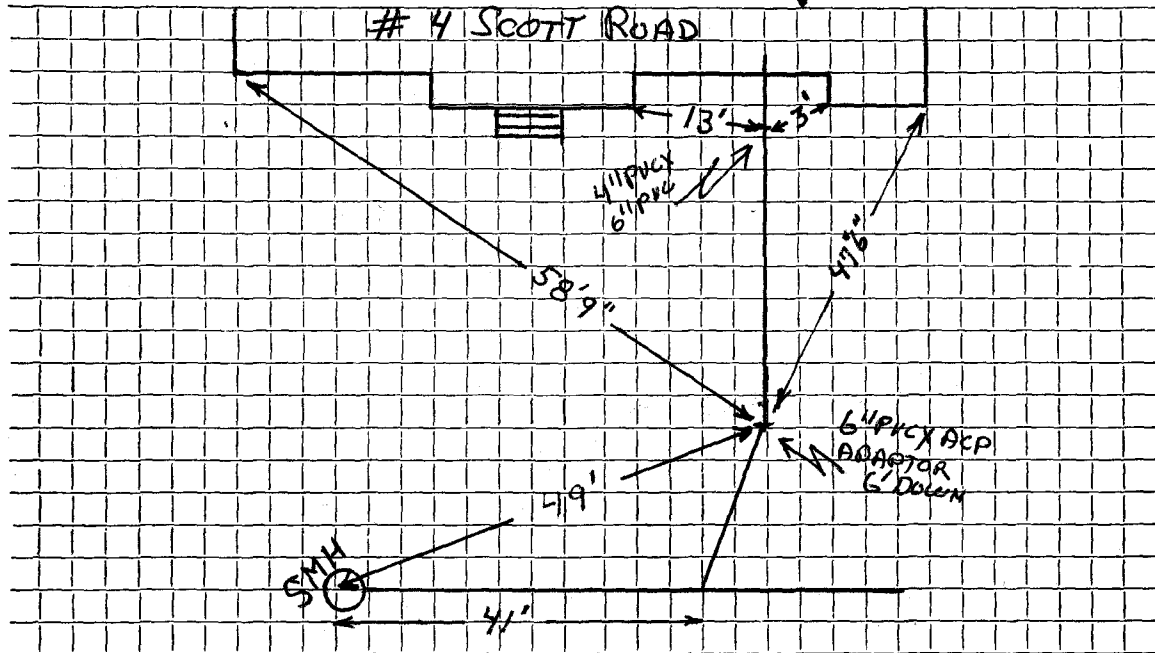

Connection made in SCOTT ROAD Street. Work completed Nov 1984

Remarks: WATER SERVICE CROSSES OVER SEWER SERVICE THREE FEET OFF CURB COCK

.....
.....