


DATE Nov 15, 1984

TOWN OF LEXINGTON — BOARD OF PUBLIC WORKS

SEWER DIVISION

Sketch of Service Here

6

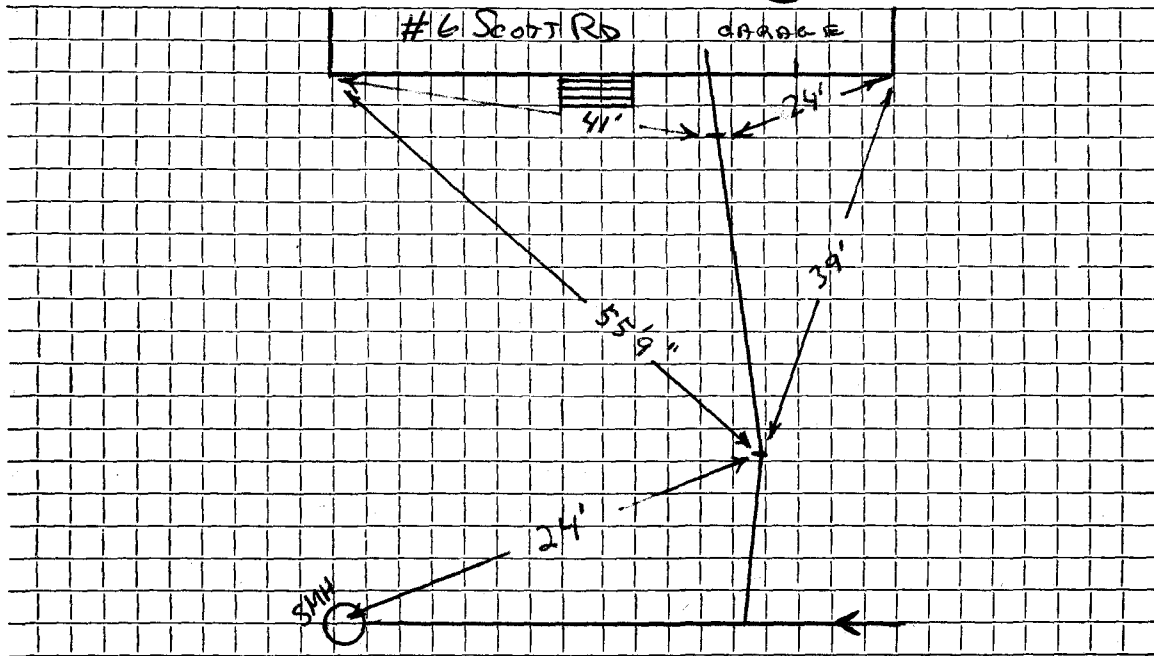

Connection made in SCOTT RD Street. Work completed Nov 1984

Remarks: WATER SERVICE CROSSER OVER ~~W.A.~~ SEWER SERVICE THREE FEET OFF CURB