


DATE _____

TOWN OF LEXINGTON — BOARD OF PUBLIC WORKS
SEWER DIVISION

Sketch of Service Here

7-9-11-13

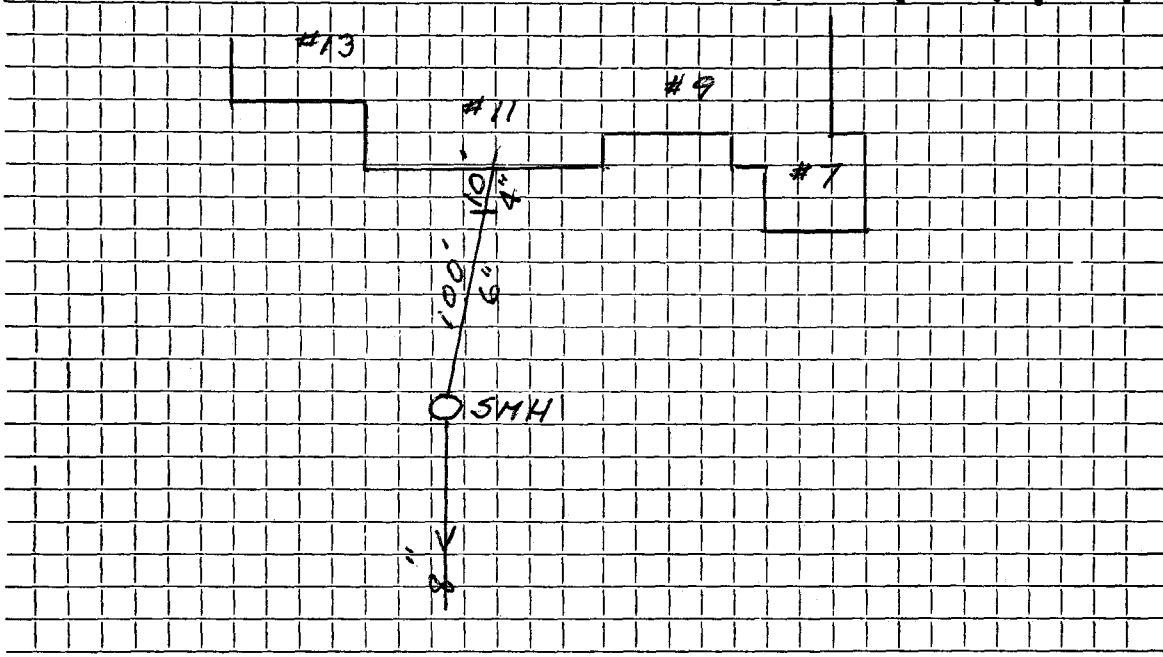

Connection made in SMH - SEABORN PLACE Street.

Work completed

Remarks:
.....
.....