


DATE _____

TOWN OF LEXINGTON — BOARD OF PUBLIC WORKS
SEWER DIVISION

Sketch of Service Here

14-16-18-20

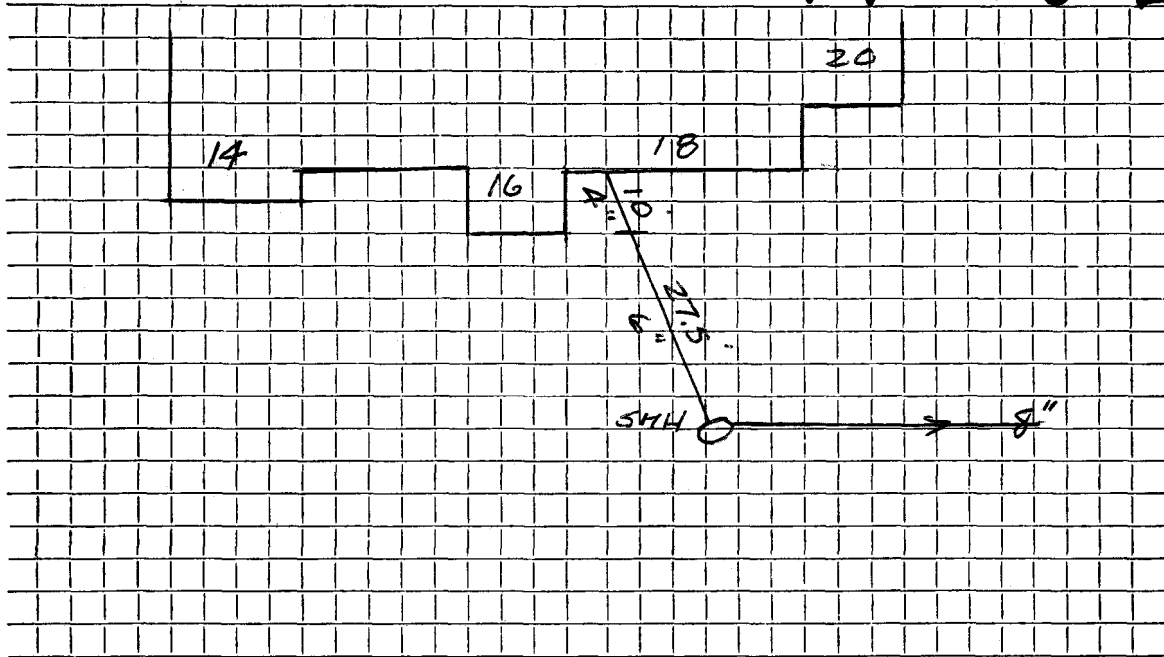

Connection made in SEABORN PLACE Street. Work completed

Remarks: SERVICED OUT OF SMH
.....
.....