


DATE _____

TOWN OF LEXINGTON — BOARD OF PUBLIC WORKS
SEWER DIVISION

Sketch of Service Here

15-17-19

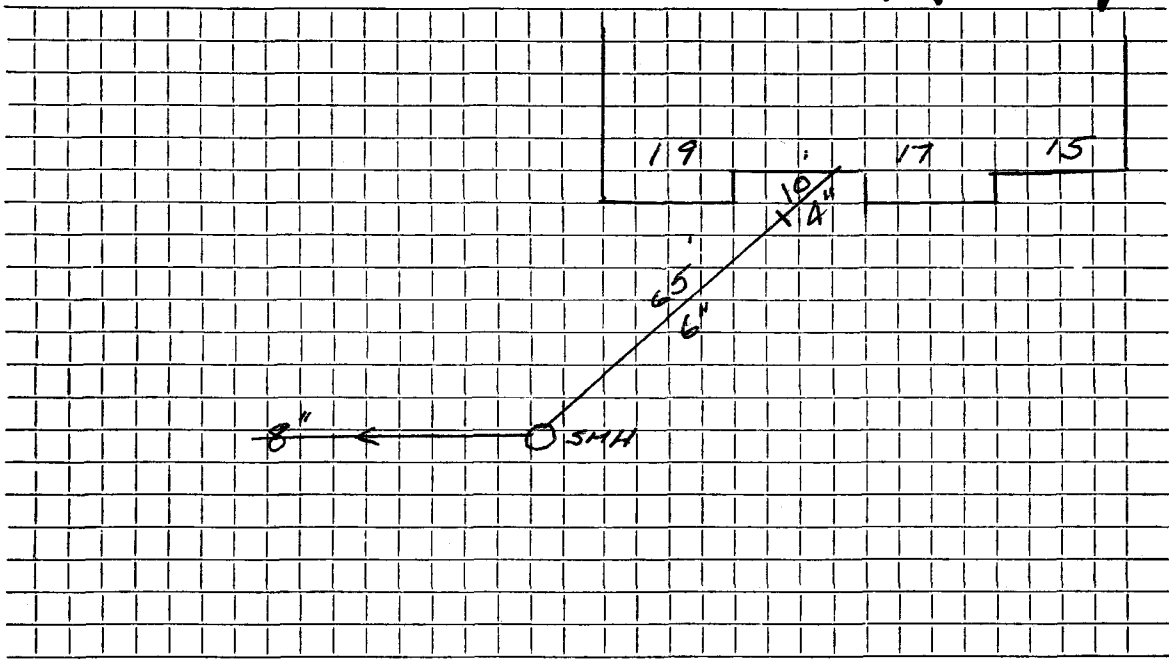

Connection made in SEABORN PLACE Street. Work completed

Remarks: SERVICE OUT OF M.H.

.....
.....