

Name

Service No.

Address 143 SHADU ST.

LOVING

Location

Kind of Pipe

Size

Size of Main

Repair ~~Renewal~~ New Service

Location

Date

Material

Amount

Total

Date

Amount

9/17/72 - 6" SDR

- 6" SDR CLEANOUT
- 6" CAP
- 6" TRU WYU
- 6" SDR RISER


DATE ~~9/14/2016~~

TOWN OF LEXINGTON — BOARD OF PUBLIC WORKS

9/2017

SEWER DIVISION

Sketch of Service Here

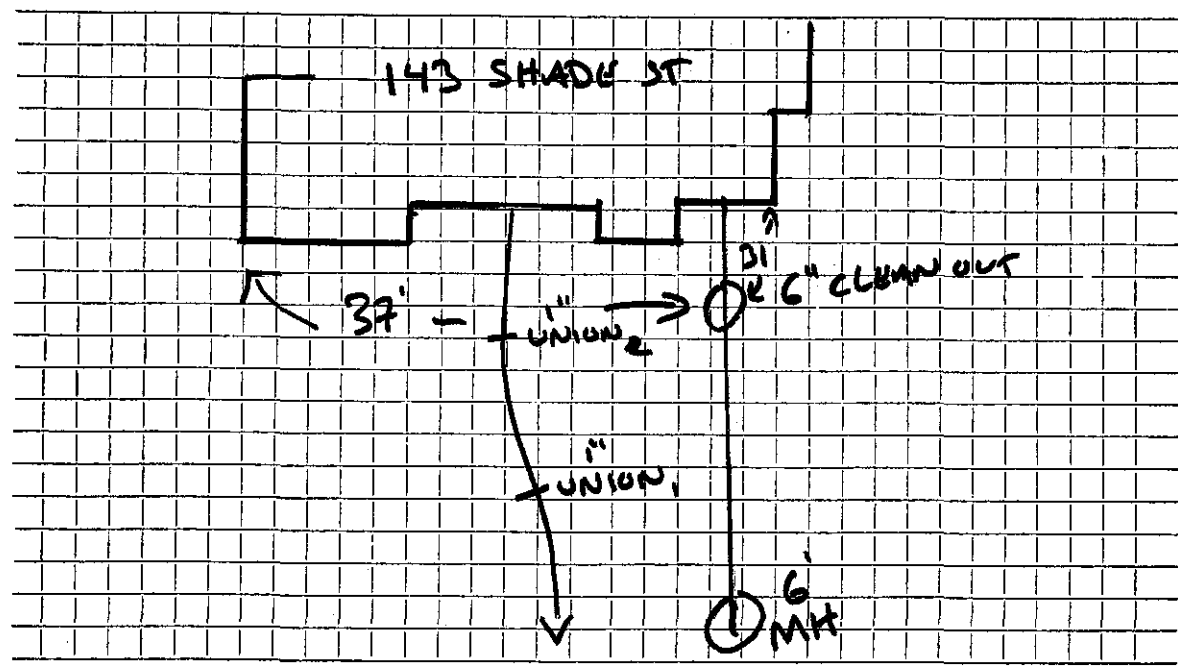

Connection made in ...SHADE... Street. Work completed LOUINU... ETC.....

Remarks:
.....
.....