

Name Marissa Liggiero, Contractor Ducharme & Dill's

Service No.

Address 75 Shade Street

Location

Kind of Pipe 6" SDR 35

Size 6"

Size of Main

Repair—Renewal—New Service

Location

Date	Material	Amount	Total	Date	Amount
------	----------	--------	-------	------	--------


	Cleanout - PVC	1			
--	----------------	---	--	--	--

	Fernco - Rubber	1			
--	-----------------	---	--	--	--

DATE 2018

TOWN OF LEXINGTON — BOARD OF PUBLIC WORKS
SEWER DIVISION

Sketch of Service Here

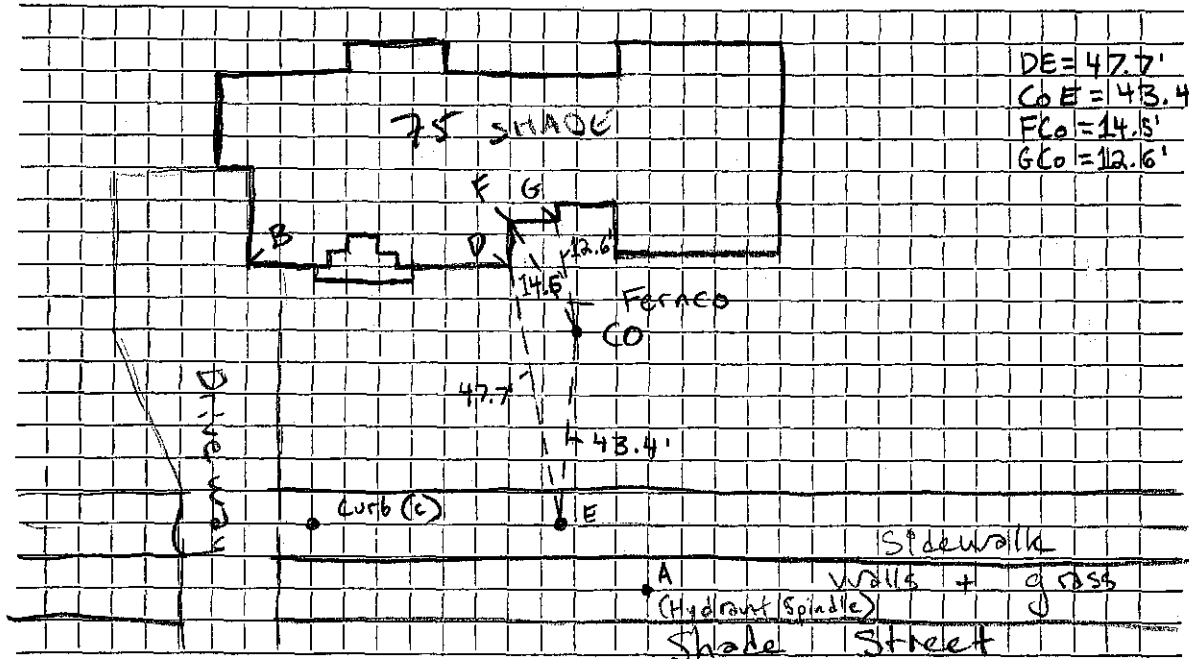

Connection made in Shade Street. Work completed

Remarks: .. Depth = 8'