


DATE 3/26/12

TOWN OF LEXINGTON — BOARD OF PUBLIC WORKS
SEWER DIVISION

Sketch of Service Here

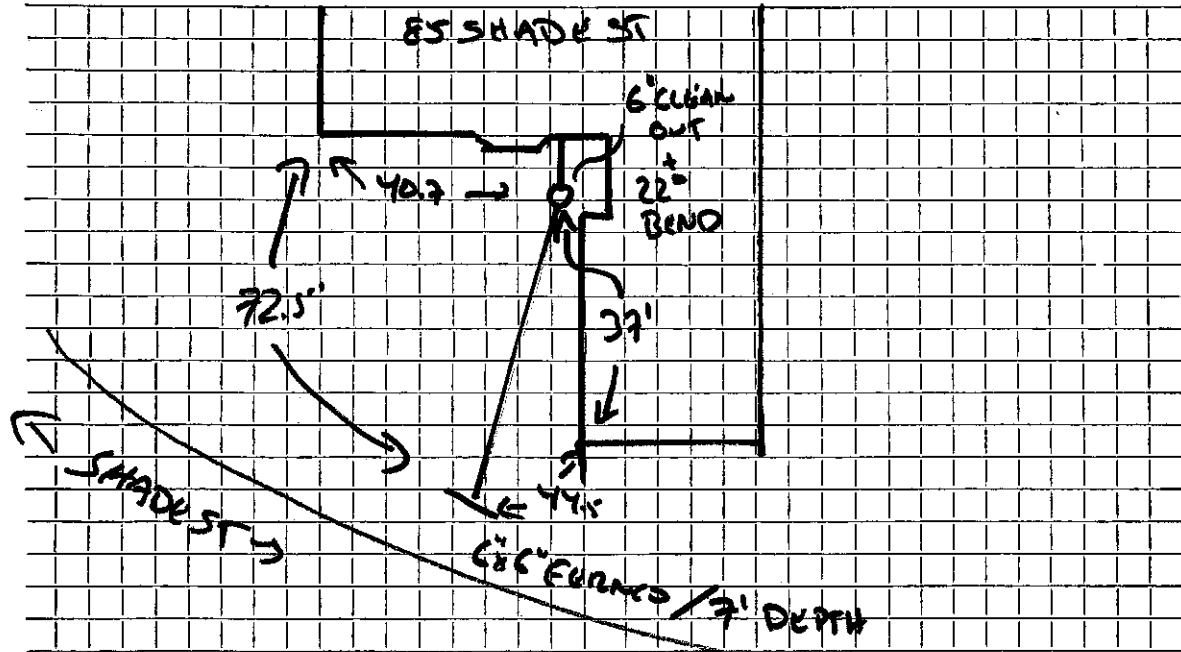

Connection made in ... SHADE ... Street. Work completed ... LOVINO EXCAVATING ...

Remarks: