




TOWN OF LEXINGTON — BOARD OF PUBLIC WORKS  
**SEWER DIVISION**

Sketch of Service Here

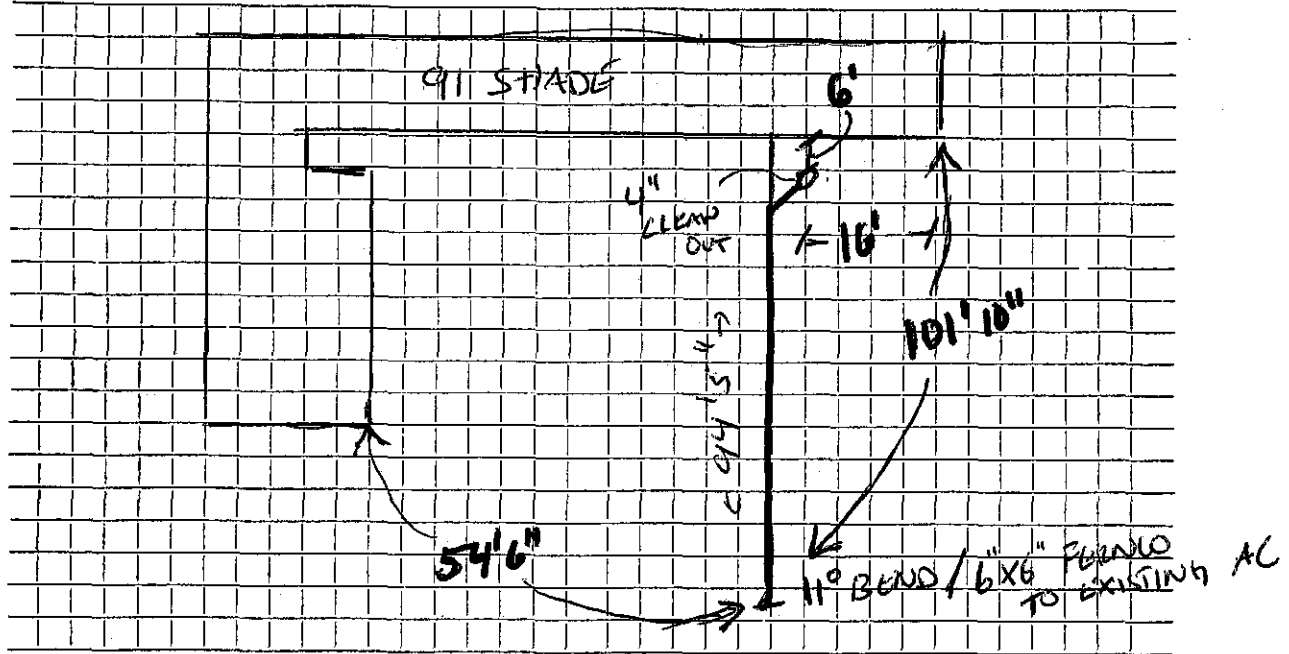

Connection made in ..... SHADE ..... Street. Work completed ..... JIM MCLAUGHLIN .....

Remarks: .....  
.....  
.....