


DATE _____

TOWN OF LEXINGTON — BOARD OF PUBLIC WORKS
SEWER DIVISION

Sketch of Service Here

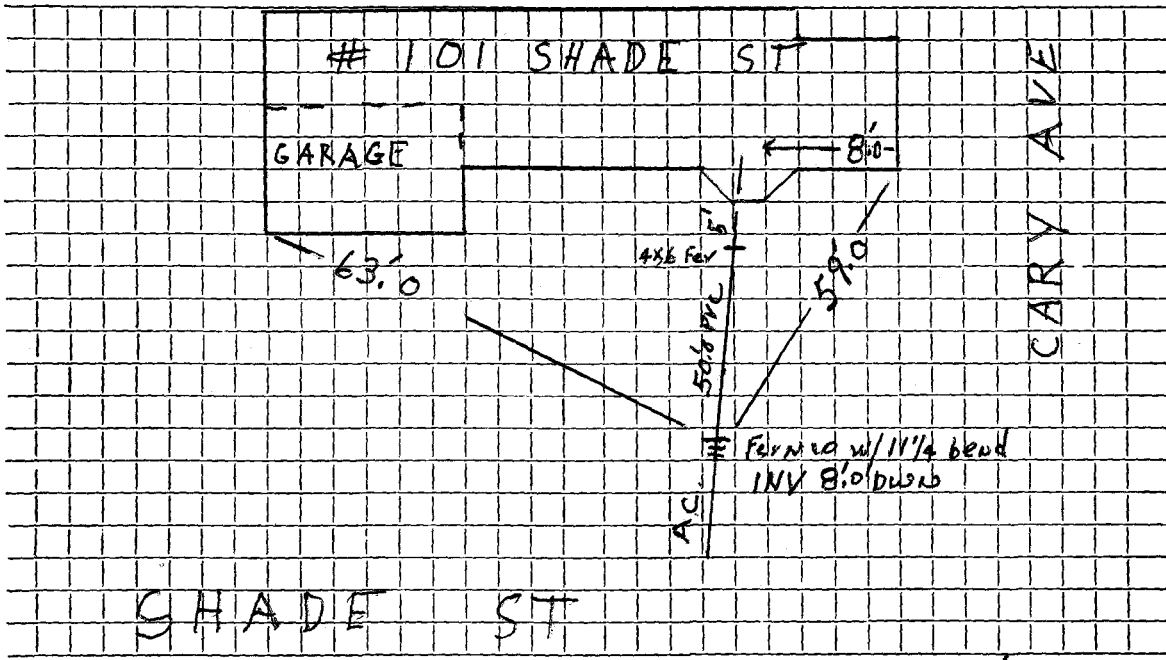

Connection made in Shade ST Street.

Work completed 2/14/05 J. McLaughlin.

Remarks:

.....

.....