


DATE 8/4/93

TOWN OF LEXINGTON — BOARD OF PUBLIC WORKS
SEWER DIVISION

Sketch of Service Here

109

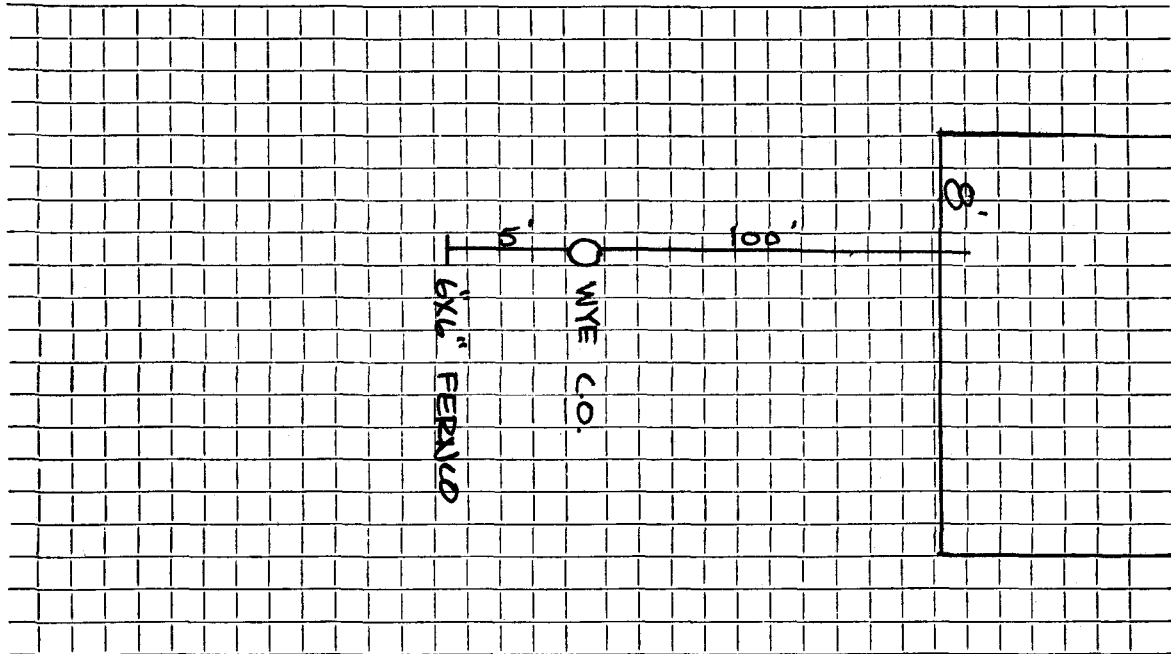

Connection made in Street. Work completed

Remarks: Original Service 6-5-62 (70'-6" Transite, 1-6"-11 1/4" Band, 1-6"-90° Elbow.) (outside 1-6"x8" saddle, 1-6"-4' chimney.)