

Name Arthur C. Weiss

Service No. 72

Address #115 Shade St.

115 Shade Street

Location

Kind of Pipe

Size 6"

Size of Main 8"

~~Repaired~~ New Service WO #7339

Location Comm 7-16-62

Date	Material	Amount	Total	Date	Amount
6-6-62	Labor 12.20			6-5-62	Deposit 300.00
6-7-62	" 105.72	117.92		7-16-62	Retund 450.7
	10% O.H.	11.79	129.71		254.93
	71' 6" Transite Pipe @.78		55.38		
	1 22 ¹ / ₂ " Transite Bend		6.21		
	1 22 ¹ / ₂ " Transite Elbow		2.24		
	1 11 ¹ / ₄ " Transite Elbow		2.24		
	1 6 x 8 Service Saddle		5.65		
	9 x 3 Patch		9.00		
	5 hrs. Town Shovel @6.50		32.50		
	4 hrs. Trucking @3.00		12.00		
			254.93		


DATE _____

TOWN OF LEXINGTON — BOARD OF PUBLIC WORKS

SEWER DIVISION

Sketch of Service Here

115

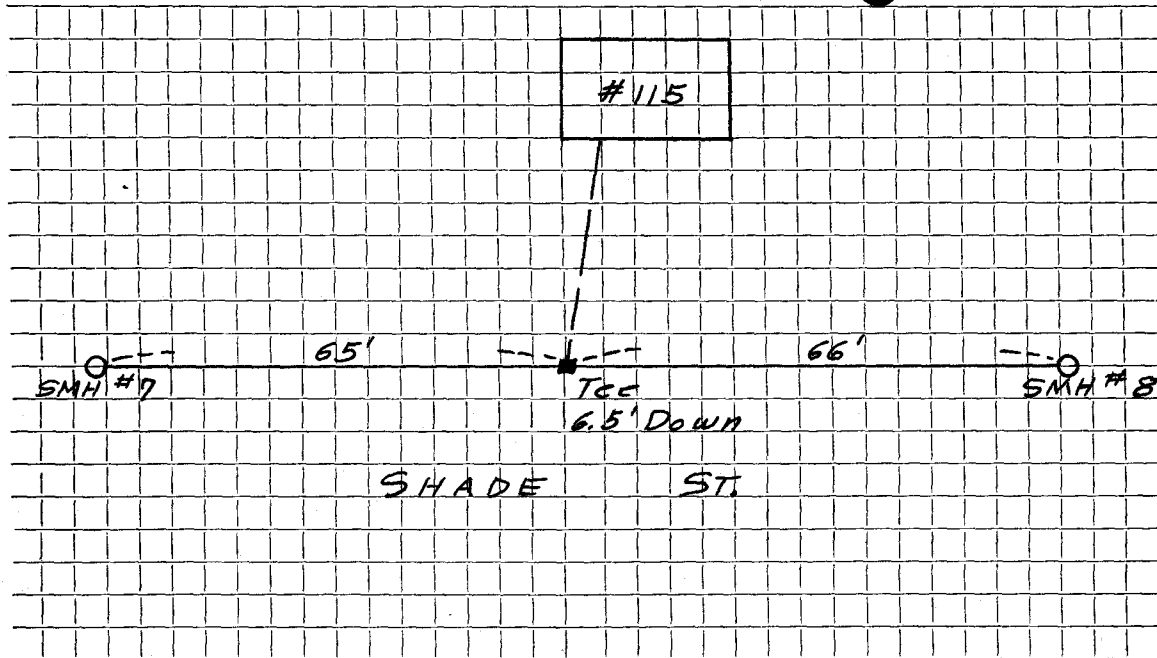

Connection made in Street. Work completed

Remarks:
.....
.....