

Name Robert W. Lenhard

Service No. 121

Address 117 Shade Street

117 Shade Street

Location

Kind of Pipe

Size 6"

Size of Main 8"

~~Repair~~ ~~Renewal~~ New Service

W.O. # 8315 Dave Eggle # 1974

Location APR 26 1972


Date	Material	Amount	Total	Date	Amount
12/13/71	Labor	118 44		12-2-71	Deposit 535 00
	10% O.H.	11 84	130 28	4-26-72	Refund 6 43
20'	6" Transite pipe @ .90		18 00		518 58
2'	6" Nipple		2 90		
1	6" Cap		2 38		
1	6" Nipple		1 28		
1	6" Saddle		15 95		
2	Ton 3/4" Stone @ 1.75		3 50		
1	30o El		4 89		
1/4	Ton Cold Patch 8.00		2 00		
2	Ton Hot Top 7.45		14 90		
3	Hrs. Shovel 6.50		19 50		
1	Hr. Truck		3 00		
			218 58		
12-13-71	65' 6" Transite pipe				
	10' 4" Cast Iron pipe				

DATE _____

TOWN OF LEXINGTON — BOARD OF PUBLIC WORKS

SEWER DIVISION

Sketch of Service Here **117**

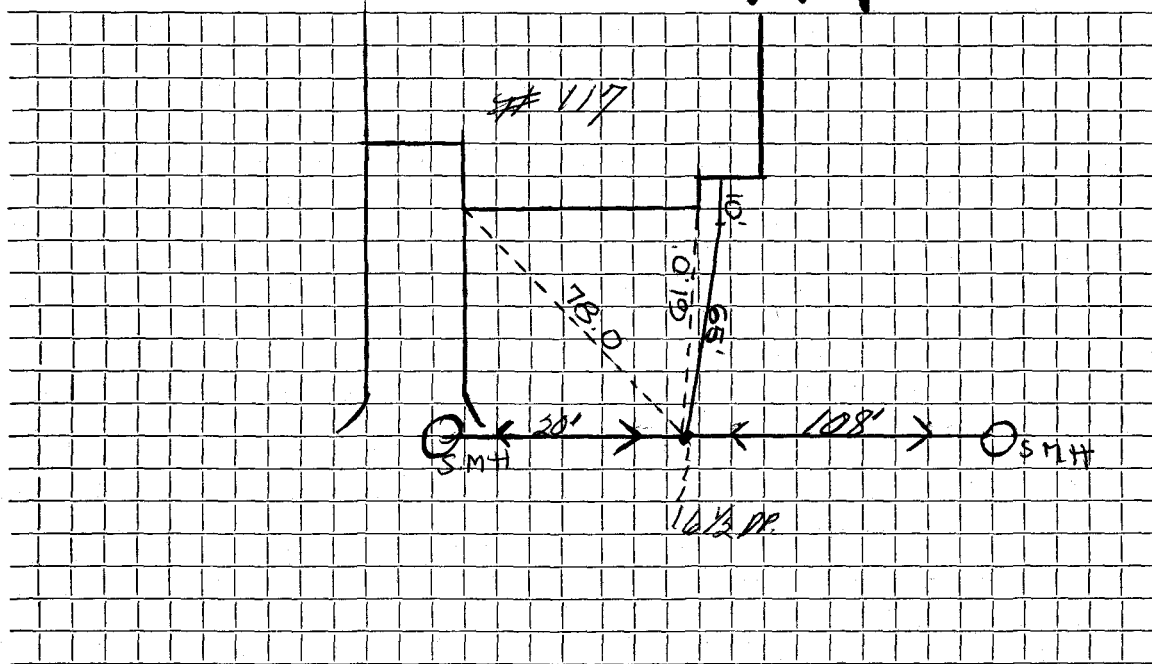

Connection made in Street. Work completed

Remarks:
.....
.....