

Name Jehu Spears

Service No. 221

Address #125 Shade St.

125 Shade Street

Location

Kind of Pipe

Size 6"

Size of Main 8"

New Service

W.C. # 7766

Location Comm 3-25-63


Date	Material	Amount	Total	Date	Amount
12-15-62	Labor 91.34			12-10-62	Deposit 256.00
12-17-62	" 24.94	116.28		4-16-63	Paid 10.36
	10% O.H.	11.63	127.91		260.36
	55' 6" Transite pipe @.82		45.10		NON CHARGE
	8 ton 3/4" Stone @1.50		12.00	12-15-62	Labor 45.68
	1 22 ¹⁰ / ₂ " Transite Elbow		2.35		
	12 x 3 Patch		12.00		
	4 hrs. Town Shovel @6.50		26.00		
	4 hrs. Trucking @3.00		12.00		
	1 hr. Trailer @3.00		3.00		
	Spring Loam & Seed		20.00		
			260.36		
					Bill sent 10.36

DATE _____

TOWN OF LEXINGTON — BOARD OF PUBLIC WORKS

SEWER DIVISION

Sketch of Service Here **125**

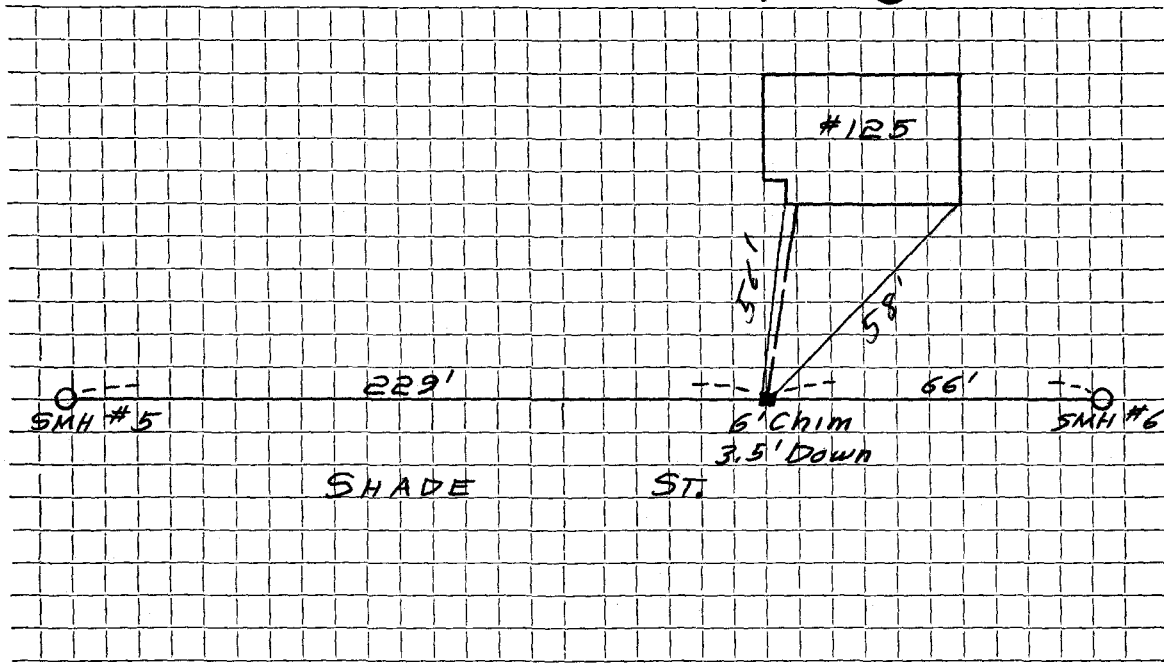


Connection made in Street. Work completed

Remarks:
.....
.....

DATE 11-1-01

TOWN OF LEXINGTON — BOARD OF PUBLIC WORKS
SEWER DIVISION

Sketch of Service Here

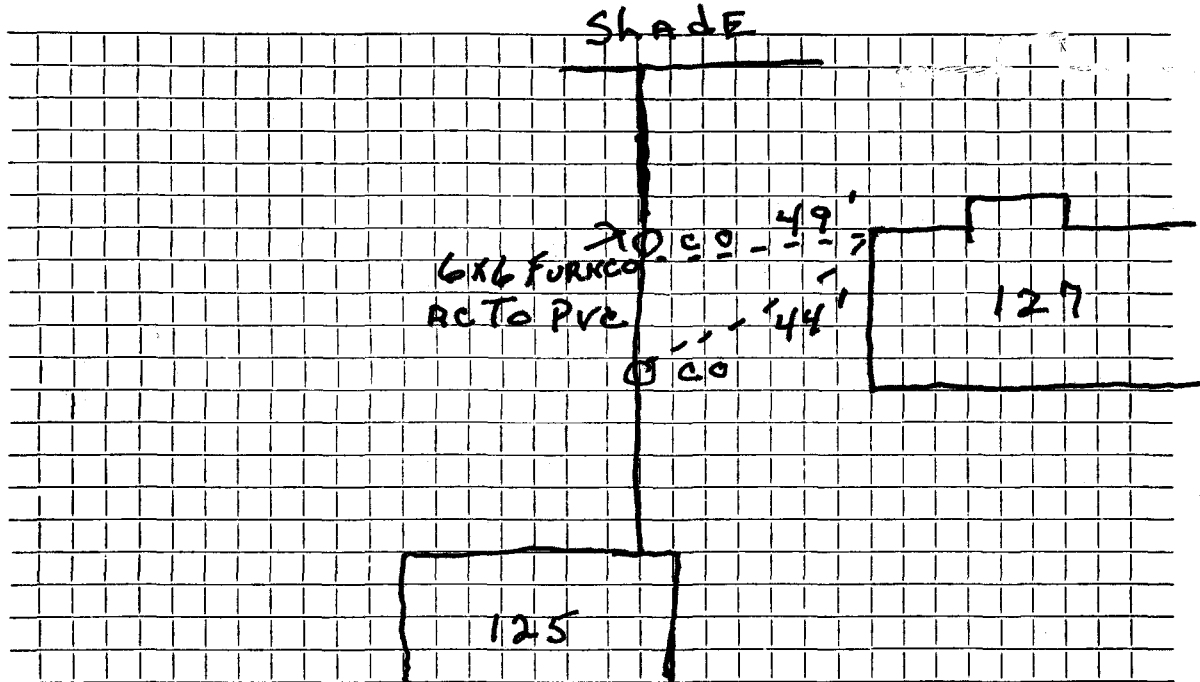

Connection made in SHADE Street. Work completed

Remarks: To c.c. CONST.