

Name Standish Hartman

Service No. #81

Address #131 Shade St.

131 Shade Street

Location

Kind of Pipe

Size 6"

Size of Main 8"

Repair—Renewal—New Service

WO# 7358


Location Comm 10-1-62

Date	Material	Amount	Total	Date	Amount
6-20-62	Labor 85.02				
6-21-62	" 12.19	97.21		6-15-62	Deposit 250.00
	10% O.H.	9.72	106.93		Refund 51.85
	49' 6" Transite Pipe @78		38.22		195.12
	1 6" Clay Elbow @45 ^o		1.85		
	1 6" Adapter		1.62		
	18X3 Patch		18.00		
	3 Hrs. Town Shovel @6.50		19.50		
	3 Hrs. Trucking @3.00		9.00		
			195.12	3/16/90	Respond + measure Repair has been made from property line to main

DATE _____

TOWN OF LEXINGTON — BOARD OF PUBLIC WORKS
SEWER DIVISION

Sketch of Service Here **131**

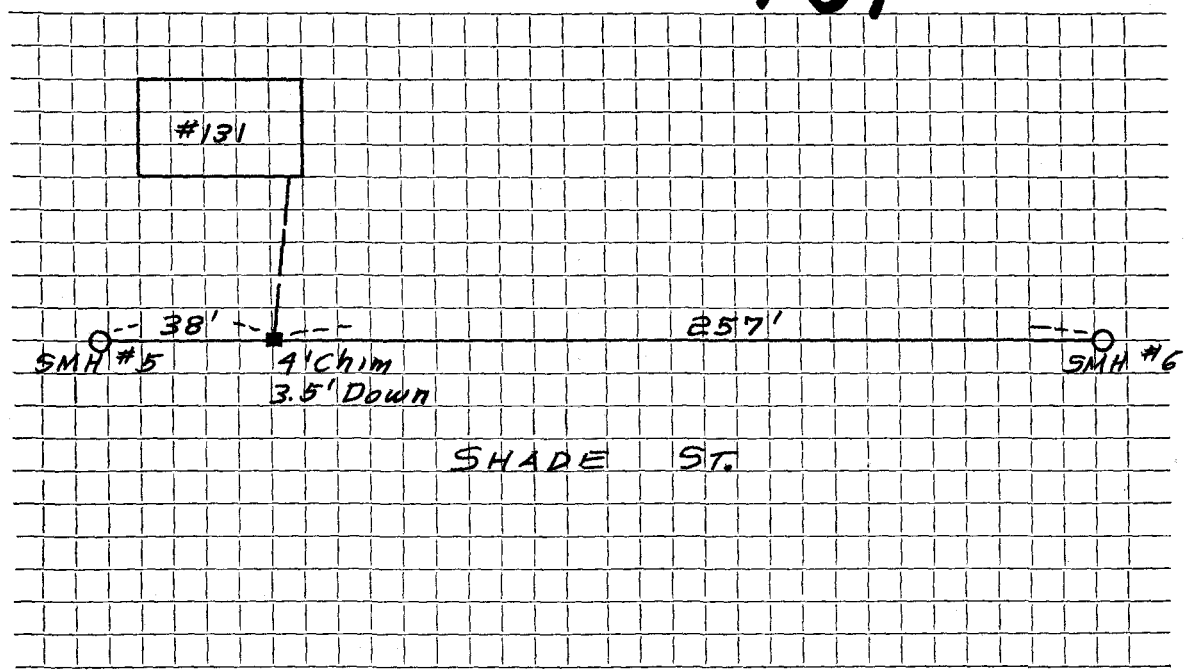

Connection made in Street. Work completed


Remarks:
.....
.....

DATE _____

TOWN OF LEXINGTON — BOARD OF PUBLIC WORKS

SEWER DIVISION

Sketch of Service Here

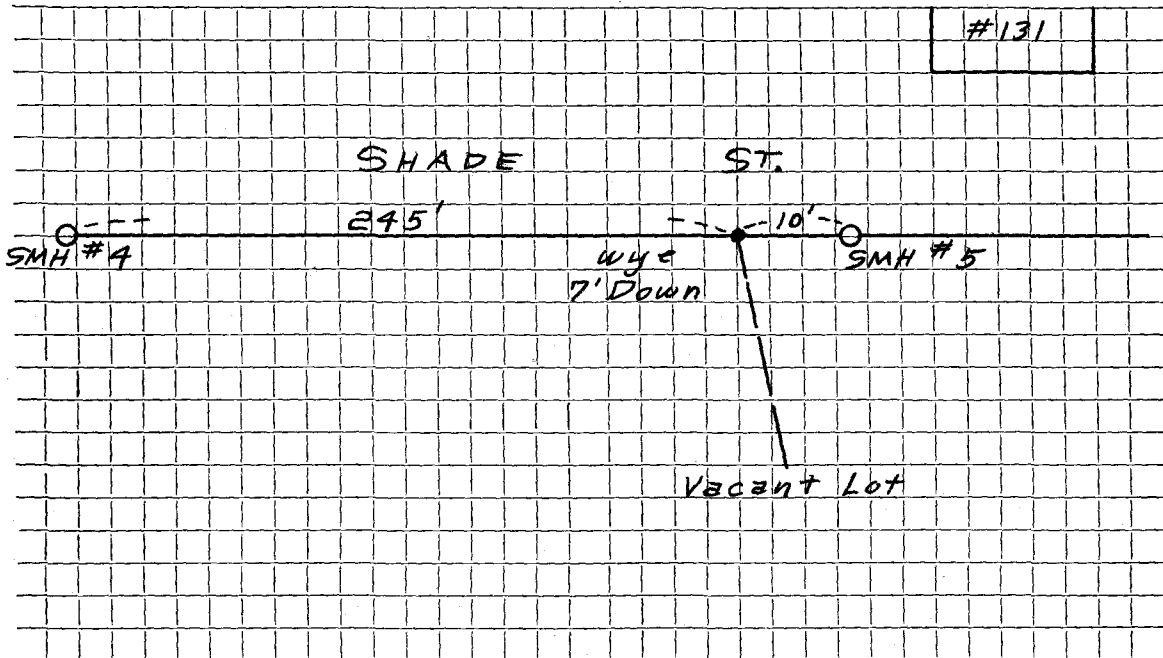

Connection made in Street. Work completed

Remarks:
.....
.....