


DATE _____

TOWN OF LEXINGTON — BOARD OF PUBLIC WORKS
SEWER DIVISION

Sketch of Service Here

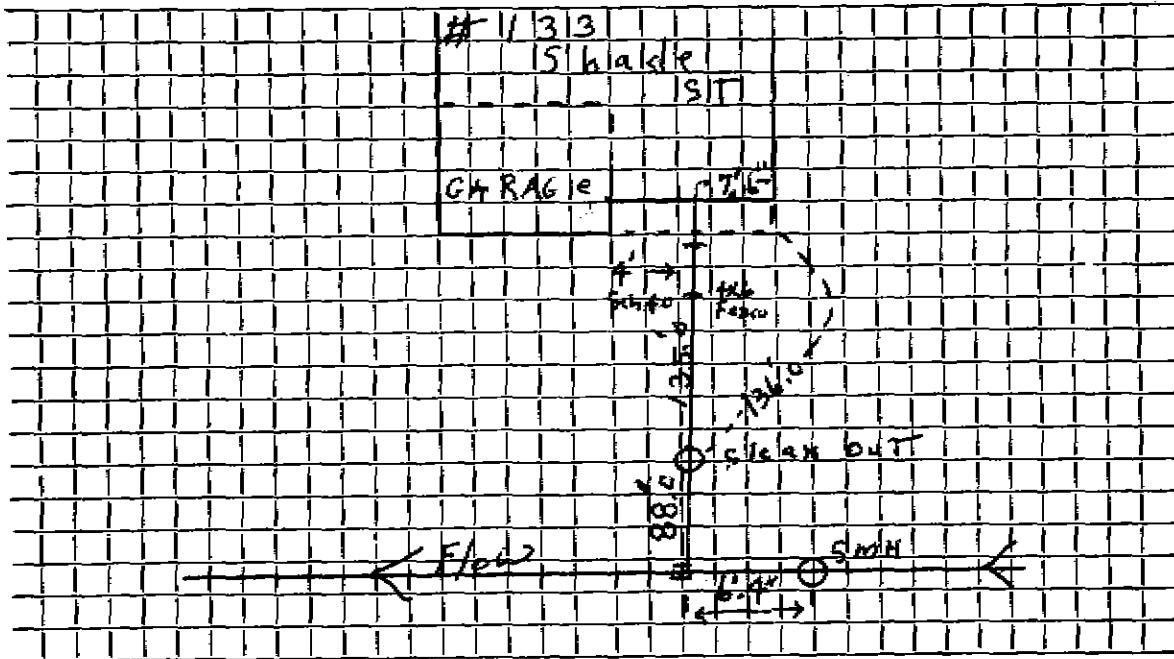

Connection made in Street. Work completed 9/9/08 J. McC.

Remarks: INST. 2' O. CHINA @ MAIN, INV. Edge of RD. 5' 6"
.....
.....