

Name **Minotti DeCicco**

Service No. **45**

Address **#137 Shade St.**

137 Shade Street

Location

Kind of Pipe

Size **6"**

Size of Main **8"**

~~Repair~~ ~~Renewal~~ ~~XXXXXX~~ **New Service** *WO# 7221*

Location *Cam 7-16-62*


Date	Material	Amount	Total	Date	Amount
5/21/62	Labor	78.11		5-21-62	300.00
5/23/62	"	31.95	110.06	7-16-62	25.55
	10% O.H.	11.01	121.07		224.25
	66' 6" Transite Pipe @ .78		51.48		
	1 90° Transite Elbow		5.40		
	3 Hrs. Town Shovel @ 6.50		19.50		
	3 Hrs. Trucking @ 3.00		9.00		
	18 X 3 Patch		18.00		
			224.45		

DATE _____

TOWN OF LEXINGTON — BOARD OF PUBLIC WORKS

SEWER DIVISION

Sketch of Service Here **137**

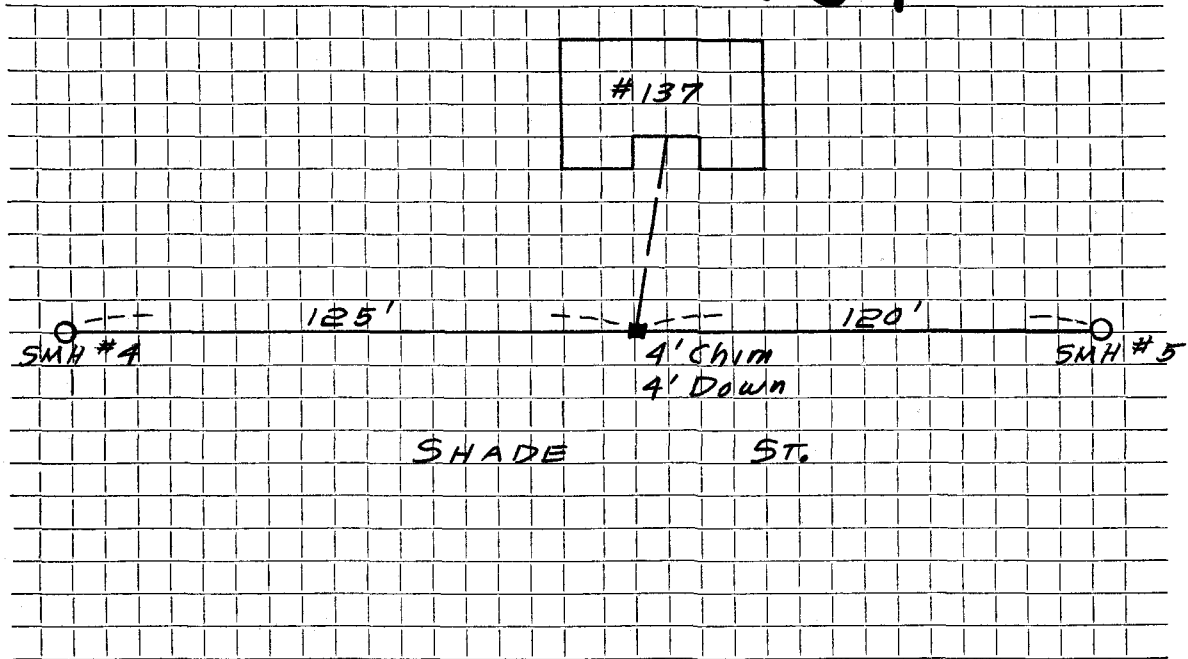

Connection made in Street. Work completed


Remarks:
.....
.....

DATE _____

TOWN OF LEXINGTON — BOARD OF PUBLIC WORKS

SEWER DIVISION

Sketch of Service Here

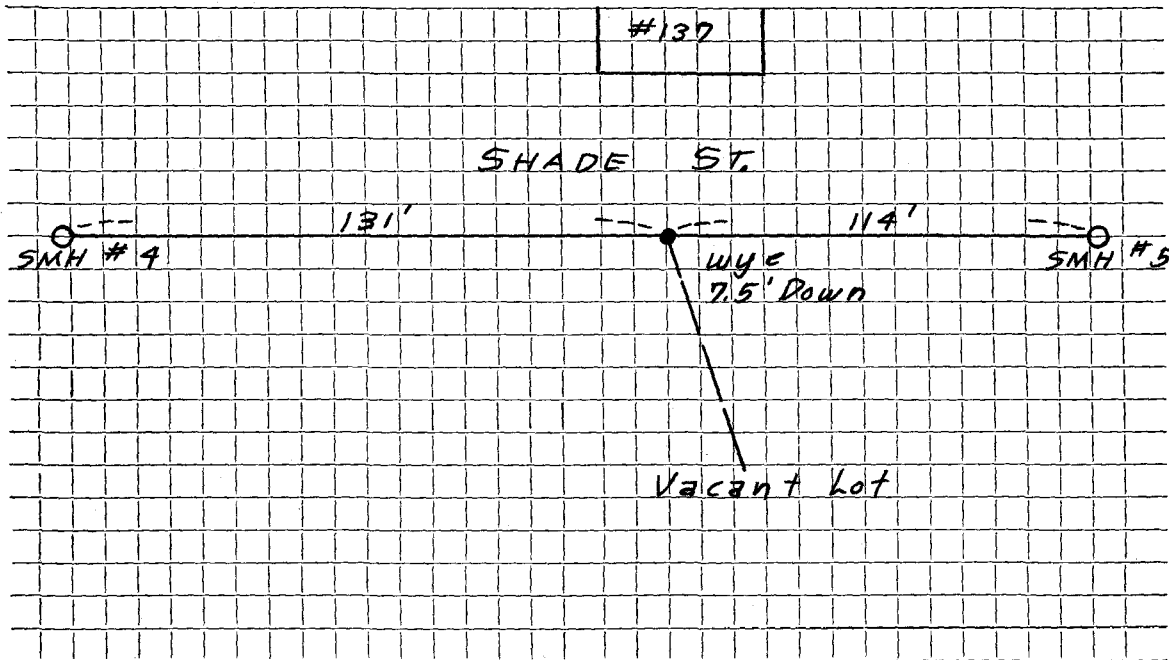

Connection made in Street. Work completed

Remarks:
.....
.....