




DATE \_\_\_\_\_

TOWN OF LEXINGTON — BOARD OF PUBLIC WORKS

SEWER DIVISION

Sketch of Service Here

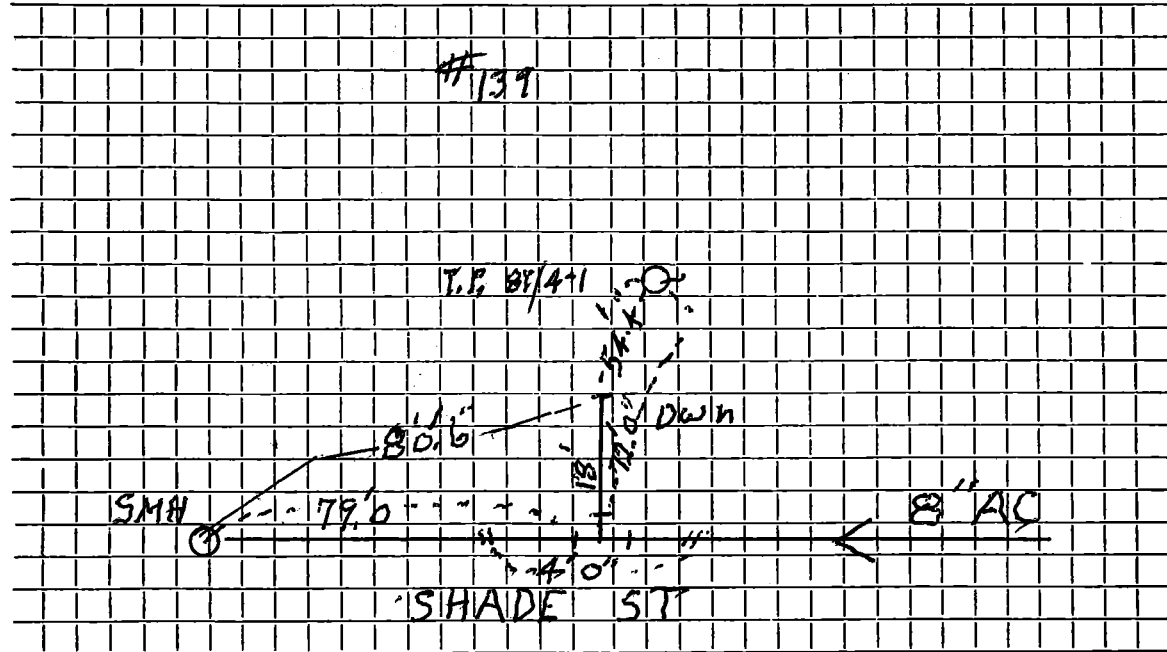

Connection made in Shade St..... Street. Work completed 5/20/11 J. McLaughlin.  
Remarks: 8x6" Tee..... for Vacant Lots. Rear of 139 Shade.....  
.....  
.....