


DATE _____

TOWN OF LEXINGTON — BOARD OF PUBLIC WORKS

SEWER DIVISION

Sketch of Service Here

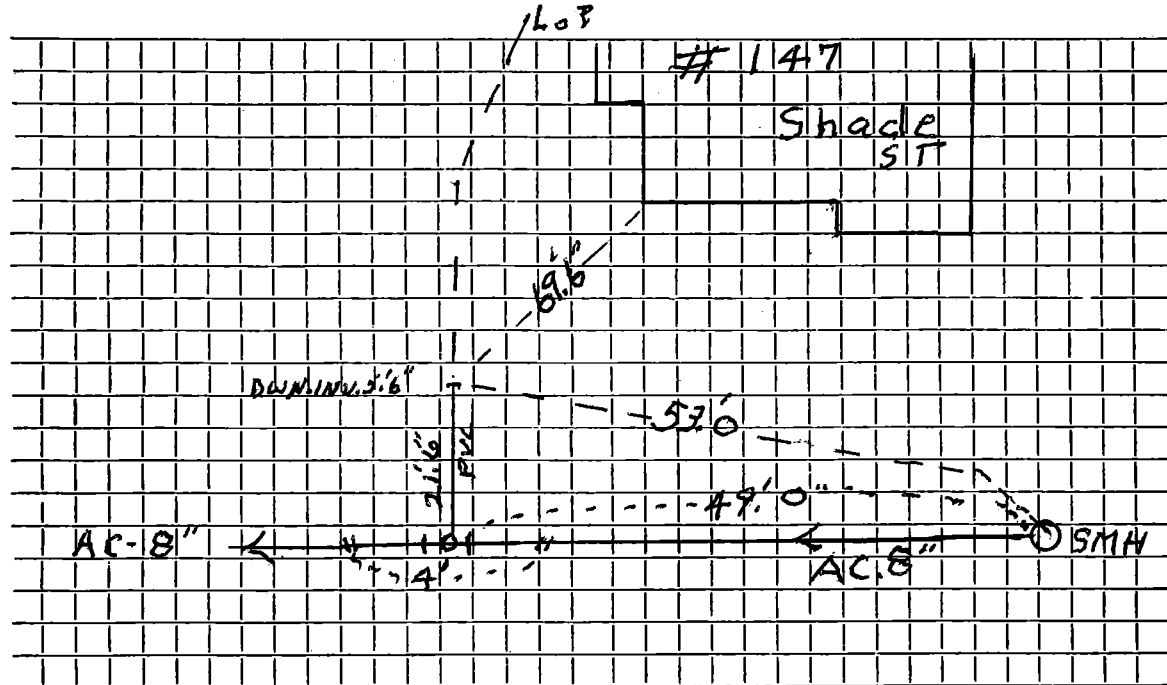

Connection made in Shade St Street. Work completed 5/20/2015

Remarks: INST. 8" x 6" DUCTIRON
147
For house to be built behind #147