

Name Richard Bell

Service No. 53

Address #147 Shade St.

147 Shade Street

Location

Kind of Pipe

Size 6"

Size of Main 8"

~~REPAIR EXISTING~~ New Service WO #7231

Location Comm 7-16-62


Date	Material	Amount	Total	Date	Amount
1/22/62	Labor 92.29			5-11-62	350 00
1/24/62	" 28.38	120 67		7-16-62	113 46
	10% O.H.	12 07	132 74		236 54
	80' 6" Transite Pipe @ .78		62 40		
	1 90° Transite Elbow		5 40		
	3 Hrs. Trucking @ 3.00		9 00		
	3 Hrs. Town Shovel @ 3.00		9 00		
	1 Hr. Loader @ 3.00		3 00		
	15 X 3 Patch		15 00		
			236 54		

DATE _____

TOWN OF LEXINGTON — BOARD OF PUBLIC WORKS

SEWER DIVISION

Sketch of Service Here **147**

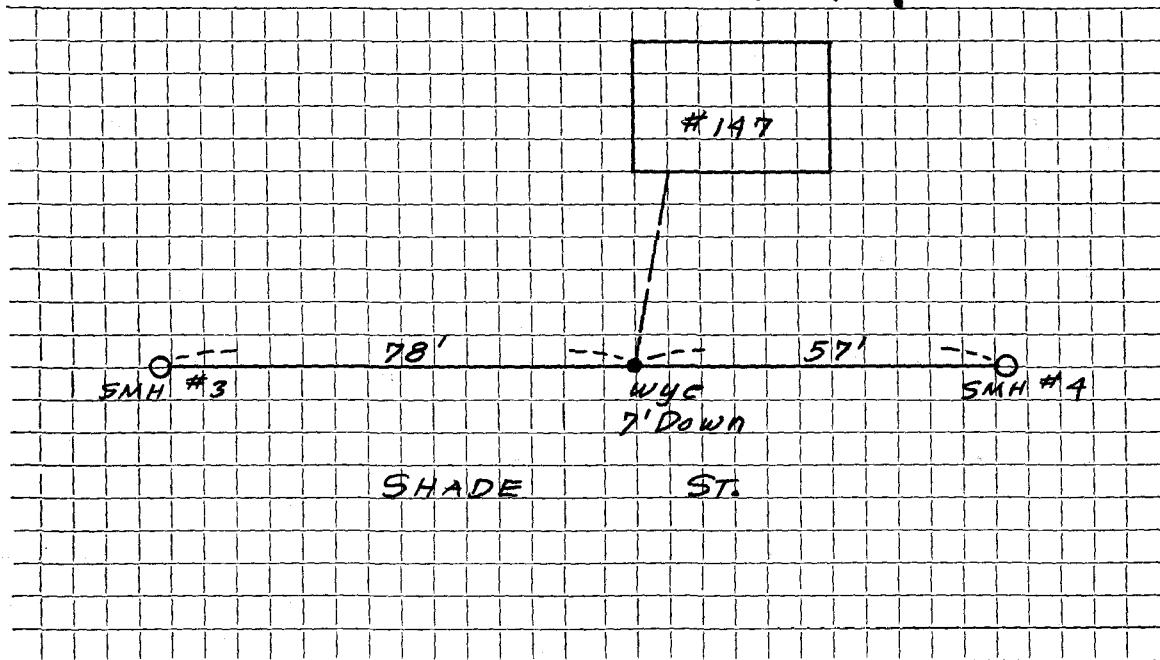

Connection made in Street. Work completed

Remarks:
.....
.....