

Name Francis J. Hunt

Service No. 92

Address 15 Shade Street

15 Shade Street

Location

Kind of Pipe

Size 6"

Size of Main 8"

Repair—Renewal—New Service W.O.#5229 Valeri #723

Location MAR 18 1968

Date		Material	Amount	Total	Date	Amount
8-28-67	12'	6" Transite pipe			8-1-67	125 00
	30'	4" Cast Iron pipe			5/1/68	125 00
8/1/67		Labor	102.80			
9/6/67		Labor	10.63			
"		Labor	13.63	127 06		
		O.H. 10%	12 71	139 77		
	15'	6" Transitepipe @ .88		13 20		
	1	Elbow		4 09		
	1½	ton hot top @ 5.80		8 70		
	4	hrs. trucking @ 3.00		12 00		
	½	hr. roller @ 3.00		1 50		
	5	hr. shovel @ 6.50		32 50		
	½	hr. compressor @ 5.00		2 50		
				214 26		

Deposit  
Deposit


DATE \_\_\_\_\_

TOWN OF LEXINGTON — BOARD OF PUBLIC WORKS

SEWER DIVISION

Sketch of Service Here

15

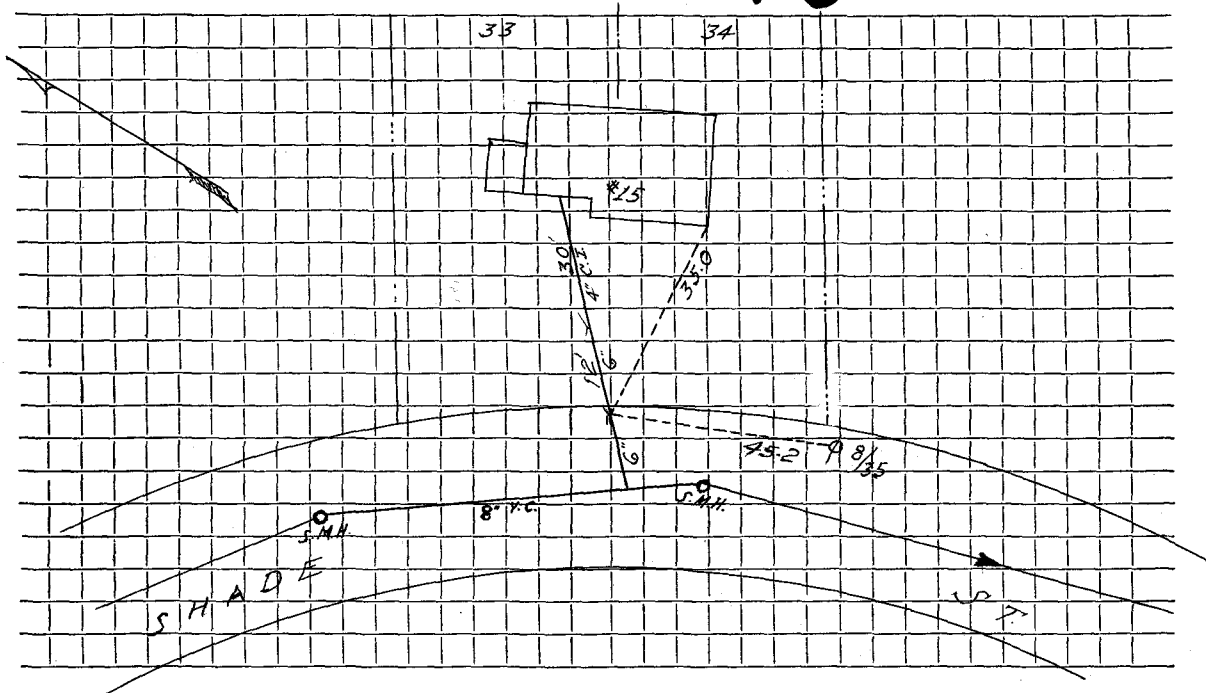

Connection made in ..... Street. Work completed .....

Remarks: .....  
.....  
.....