

Name Rose Doll

Service No. 52

Address 151 Shade St.

151 Shade Street

Location

Kind of Pipe

Size 6"

Size of Main 8"

~~Repair Service~~ New Service

WO# 7230

Location Comm 7-16-62


Date	Material	Amount	Total	Date	Amount
5/23/62	Labor	60.33		5-11-62	350 00
5/24/62	"	63.90		7-16-62	35 50
5/25/62	"	17.73	141 96		314 50
	10% O.H.	14 20	156 16	7-30-61	25 50
	84' 6" Transite Pipe @ .78		65 52		289 00
	2 22 1/2° Transite Bends @ 6.21		12 42		
	1 90° Transite Elbow		5 40		
	3 Hrs. Town Shovel @ 6.50		19 50	O.K.	
	4 Hrs. Trucking @ 3.00		12 00		
	3 Hrs. Town Shovel @ 5.50		16 50		
	4 Hrs. Trucking @ 3.00		12 00		
	15 X 3 Patch		15 00		
			314 50		
			289 00	S.B.	

DATE _____

TOWN OF LEXINGTON — BOARD OF PUBLIC WORKS

SEWER DIVISION

Sketch of Service Here **151**

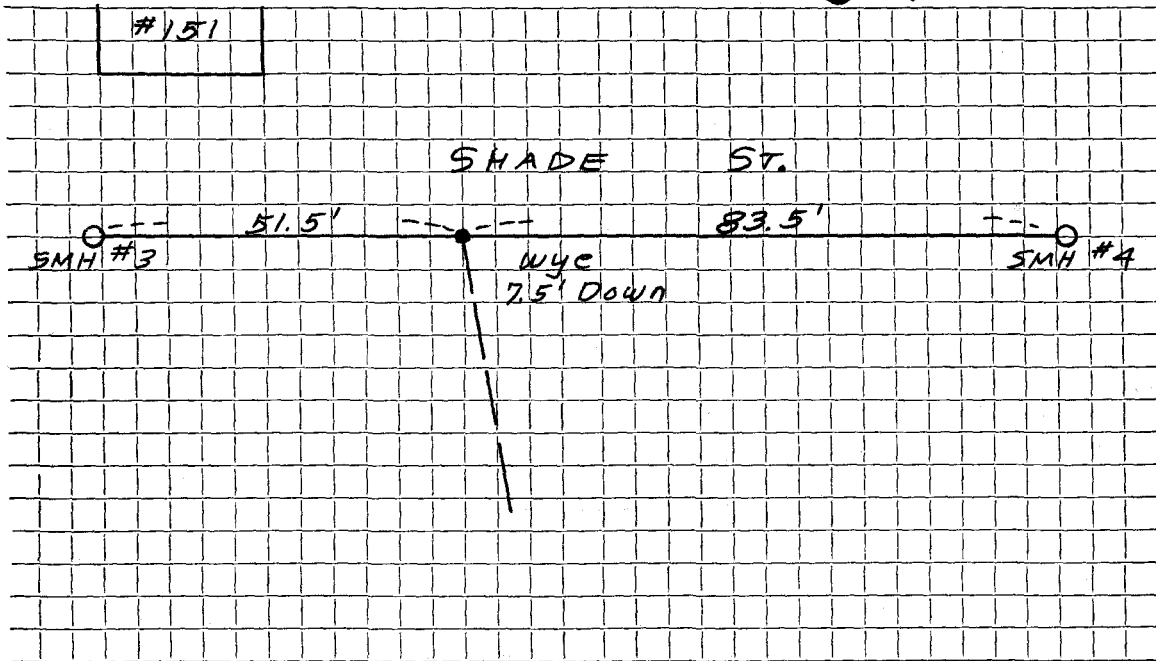

Connection made in Street. Work completed

Remarks:
.....
.....