

Name Arthur Lannquist

Service No. 15

Address #153 Shade St.

153 Shade Street

Location

Kind of Pipe

Size 6"

Size of Main 8"

~~Repair - Renewal~~ New Service W.O. #3192

Valve # 2435

Location Comm 7-28-75

Date	Material	Amount	Total	Date	Amount
4-14-75	Labor	\$ 99.32		7-28-75	Deposit
	10% O.H.	9.93	\$109.25	7-28-75	Refund
10'	6" Transite Pipe	@1.27	12.70		241.00
1	5' x 6" Nip	@1.40/Ft.	7.00		31.83
1	1" x 6" Nip		2.51		208.17
1	6" x 6" Nip		1.76		
1	8" x 6" C.I. Saddle		11.97		
1	90° Elbow		5.63		
1	6" Cap		3.75		
1/2	Ton Cold Patch		6.10		
1	5' x 9' Patch		30.00		
1	Hr. Trucking		3.00		
1	Hr. Pick up		1.50		
2	Hrs. Backhoe	@6.50	13.00		
4/24/75	62' 6" Transite pipe		\$208.17		
	10' 4" Cast Iron pipe				


DATE _____

TOWN OF LEXINGTON — BOARD OF PUBLIC WORKS

SEWER DIVISION

Sketch of Service Here

153

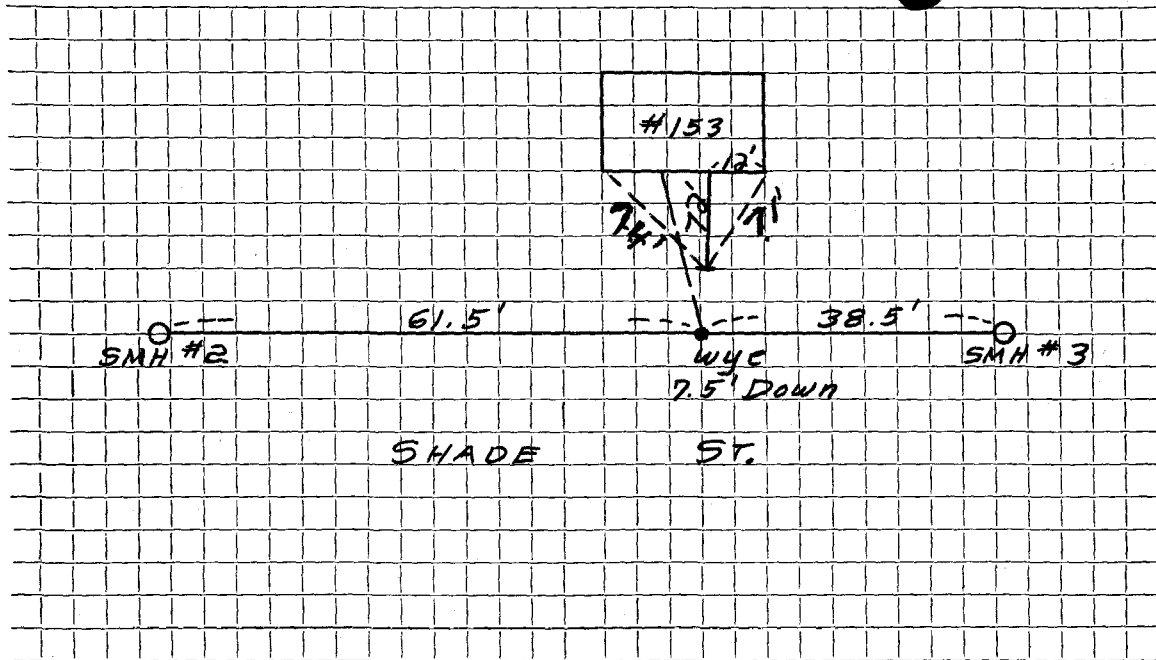

Connection made in Shade Street. Work completed

Remarks:
.....
.....