


DATE 10/29/2020

TOWN OF LEXINGTON — BOARD OF PUBLIC WORKS
SEWER DIVISION

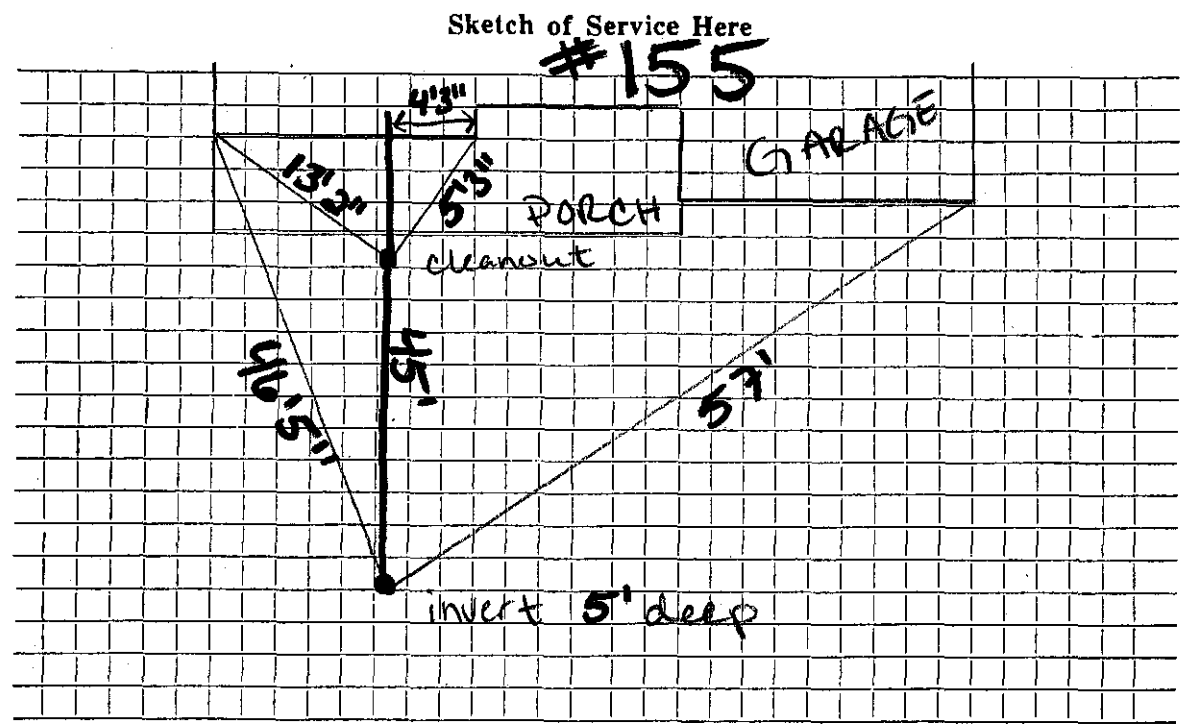

Connection made in Shade Street. Work completed

Remarks: depth @ cleanout = 7'6"