

Name Garry Margolius

Service No. 63

Address #159 Shade St.

159 Shade Street

Location

Kind of Pipe

Size 6"

Size of Main 8"

~~Repair - Renewal -~~ New Service

WO # 7312

Location Comm 7-16-62

Date	Material	Amount	Total	Date	Amount
1/1/62	Labor	92 29		5-23-62	250 00
	10% O.H.	9 23	101 52	7-16-62	50 23
	52' 6" Transite Pipe @ .78		40 56		199 77
	2 22 1/2° Elbows @ 2.24		4 48		
	1 22 1/2° Transite Bends		6 21		
	4 Hrs. Town Shovel @ 6.50		26 00		
	2 Hrs. Trucking @ 3.00		6 00		
	15 X 3 Patch		15 00		
			199 77		


DATE _____

TOWN OF LEXINGTON — BOARD OF PUBLIC WORKS

SEWER DIVISION

Sketch of Service Here

159

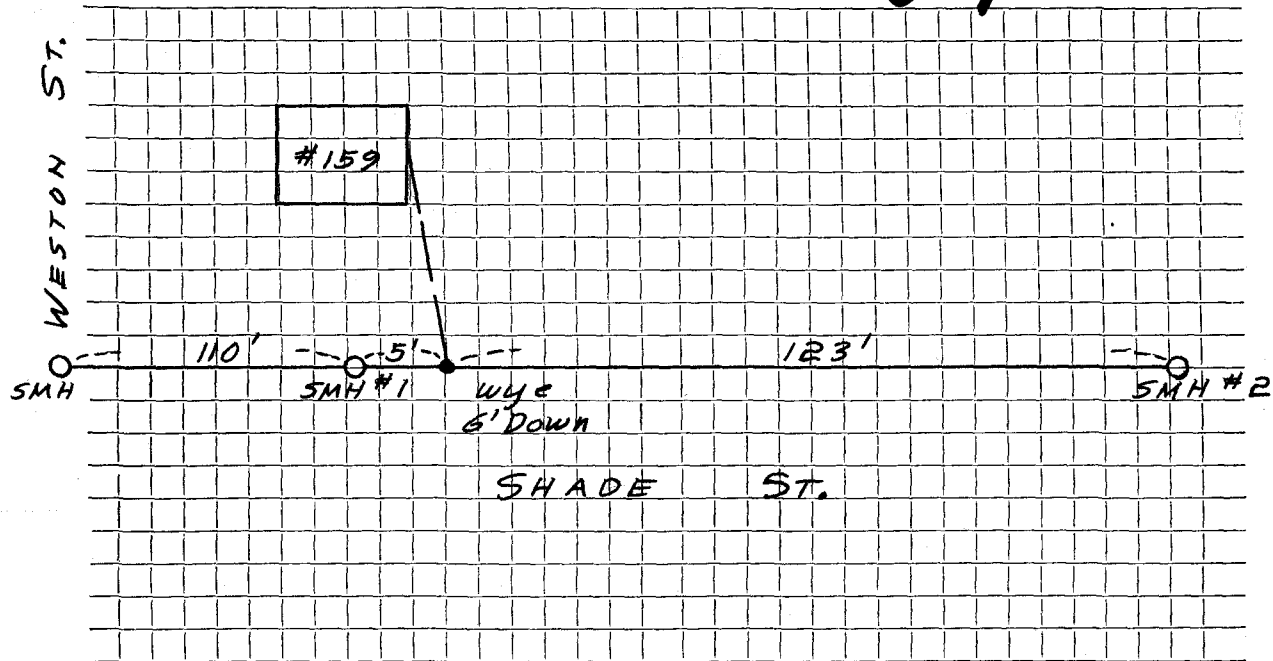

Connection made in Street. Work completed

Remarks:
.....
.....