


DATE _____

TOWN OF LEXINGTON — BOARD OF PUBLIC WORKS
SEWER DIVISION

Sketch of Service Here

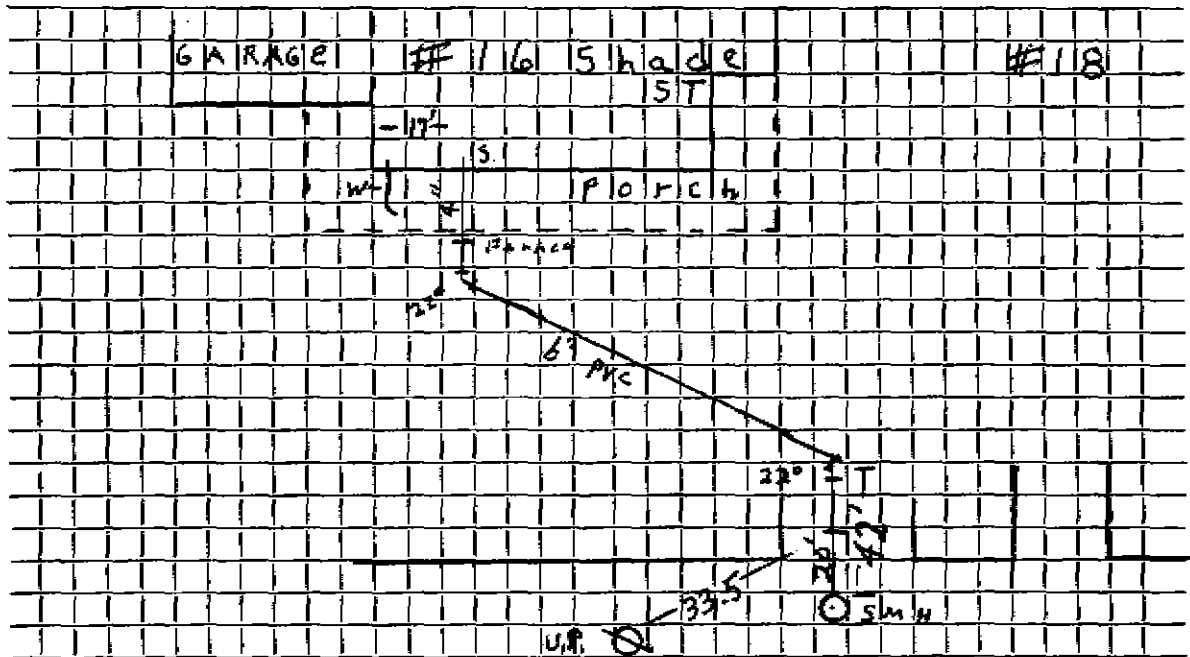

Connection made in Street. Work completed 12/11/07.....

Remarks: Sewer goes INTO Man hole.
This info. off. 2007. T.C. Card