

Name W.E. Coombs

Service No. 68

Address 17 Shade Street

17 Shade Street

Location

Kind of Pipe

Size 6"

Size of Main 8"

Repair ~~RENEWAL~~ ~~NEW SERVICE~~ Dave Eagle #1163  
W.O. #7212 New Service


Location NOV 18 1968

Date	Material	Amount	Total	Date	Amount
8/21/68	Labor	134.90		8-21-68	Deposit
8/22/68	Labor	138.82		1-21-69	PAID
9/13/68	Labor	29.60	303 32		
	10% O.H.	30 33	333 65		
	25' 6" Transite @ .88		22 00		
	1 8 X 6 Saddle		5 50		
	1 90° Elbow		4 09		
	1 Load Sand		14 00		NON CHARGE
	26 Sticks Dynamite @ .27		7 02	8-21-68	Labor
	9 Caps @ .33		2 97		(Water Break)
	4 Ton hot top @ 5.80		23 20		
	4½ hrs. Trucking @ 3.00		13 50		
	2½ Hrs. Trucing @ 1.50		3 75		
	4 Hrs. Shovel @ 6.50		26 00		
	4½ Hrs. Compressor @ 5.00		22 50	½	Bill sent 225.00
	1 Hr. Loader		4 00	1	Hr. Roller @ 3.00
9-2-68	26' 6" Transite pipe				Hr. Trailer
	10' 4" Cast Iron				
					\$ 485 68

DATE \_\_\_\_\_

TOWN OF LEXINGTON — BOARD OF PUBLIC WORKS  
**SEWER DIVISION**

Sketch of Service Here **17**

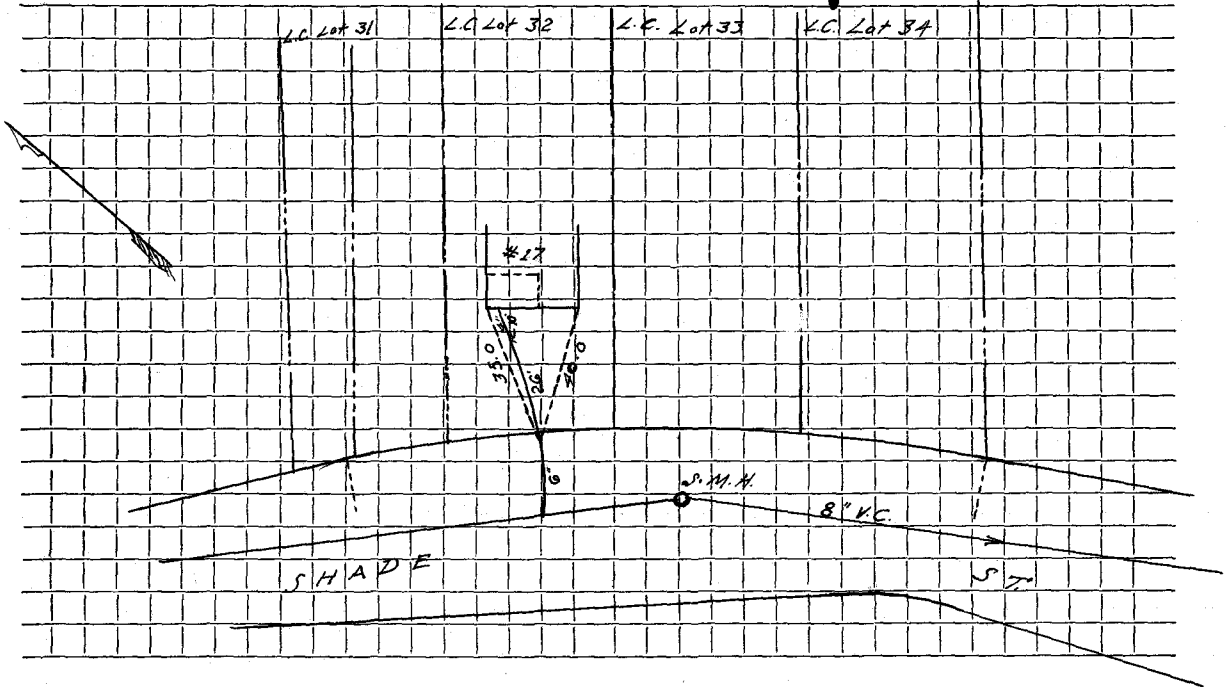

Connection made in ..... Street. Work completed .....

Remarks: .....  
.....  
.....