

Name Arthur Ballou

Service No. 61

Address 21 Shade Street

21 Shade Street

Location

Kind of Pipe

Size 6"

Size of Main 8"

Repair—Renewal—New Service Eagle #1327
W.O.#5647 Service to Corp


Location AUG 5 1968

Date	Material	Amount	Total	Date	Amount
10-31-67	Labor 187.60			1-13-67	Deposit 125 00
11-1-67	" 50.71	238.31		10-23-68	PAID 60 00
	10% O.H.	23.83	262.14	10-9-68	PAID 150 00
28'	6" Transite pipe @.88		24.64	12-3-68	PAID 53 10
1	90° Transite Elbow		4.09		388 10
1	22½° Transite Elbow		2.35		
1	6" Nipple		.65		
1	Saddle		5.50		
½	bag cement @1.55		.78		
1	load gravel		1.40		
1	ton Hot top @5.80		5.80		
1	ton Crushed stone		2.75		
4	hrs. Trucking @3.00		12.00		
8	hrs. Town Shovel @6.50		52.00	1-7-91	S.B.
1	hr. Loader		4.00		
1	hr. Roller & Trailer		5.00		
1	hr. Compressor		5.00		
			386.10		
5-13-69	32' 6" Transite pipe				25/10
10'	4" Cast Iron pipe				

DATE 5 MAR. 91

TOWN OF LEXINGTON — BOARD OF PUBLIC WORKS
SEWER DIVISION

Sketch of Service Here

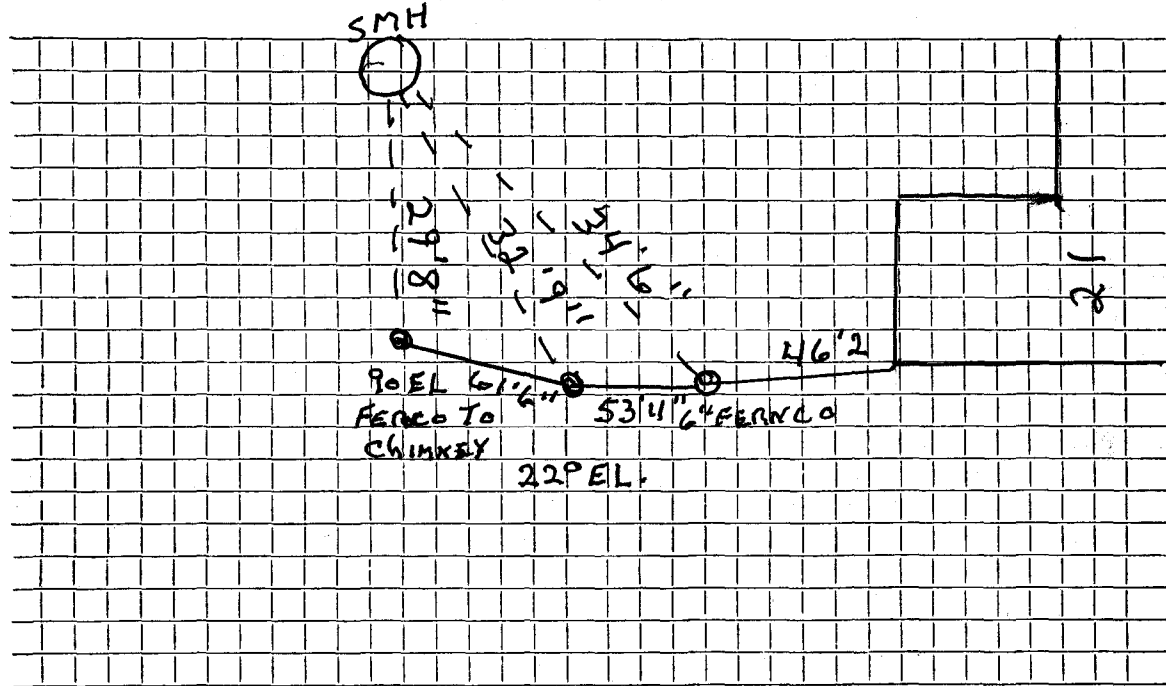


Connection made in Street. Work completed

Remarks:
.....
.....

DATE _____

TOWN OF LEXINGTON — BOARD OF PUBLIC WORKS
SEWER DIVISION

Sketch of Service Here **21**

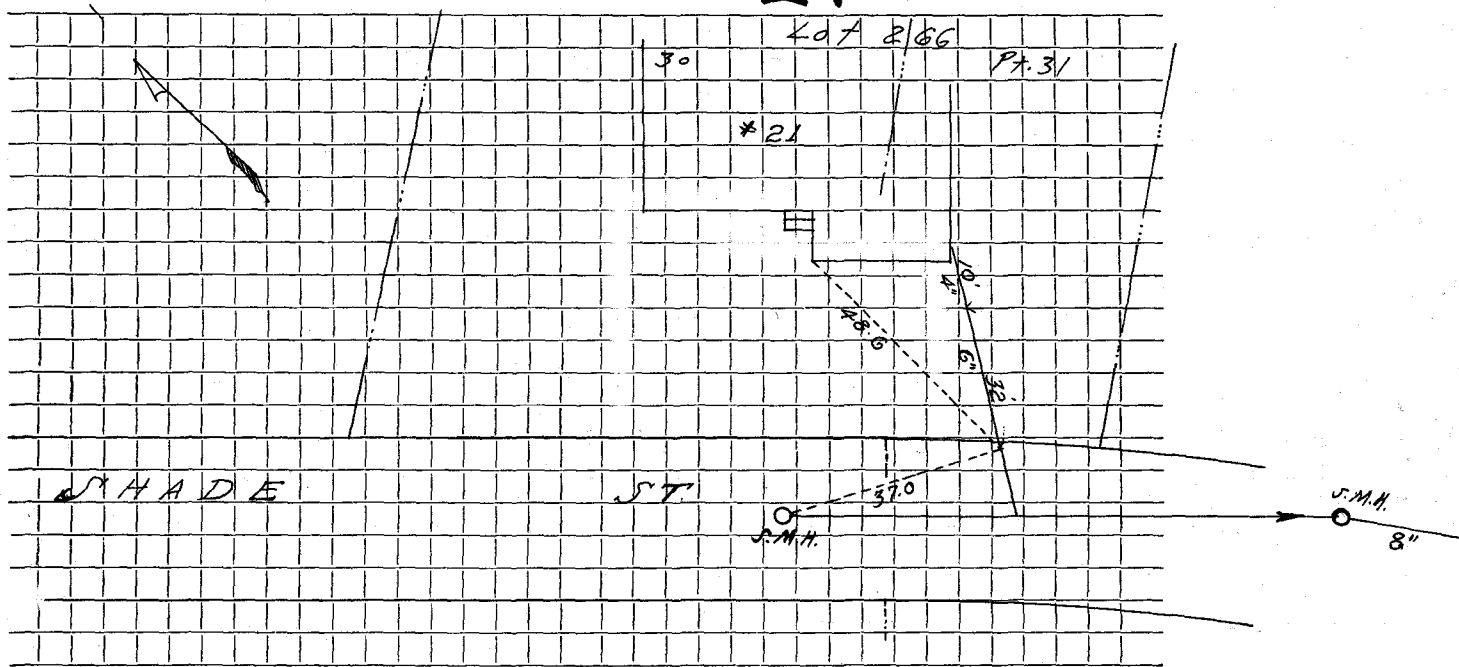

Connection made in Street. Work completed

Remarks:
.....
.....