

Name Curtain Realty Trust

Service No. 47

Address #25 Shade St.

25 Shade Street

Location

Kind of Pipe

Size 6"

Size of Main 8"

Repair—Renewal—New Service WO #4674 Eagle #2852

Location

Date	Material	Amount	Total	Date	Amount
6/13/76	labor 319.13			7-7-76	Deposit 350.00
6/14/76	labor 121.60			1-13-77	Paid 244.31
2/22/76	labor 22.36	463.09			244.31
	10%OH	46.31	509.40		
2	10' 6" Transite Pipe @ 1.48		29.60		
1	3' 6" Transite Pipe @ 8.26		8.26		
	Patch 18 by 6		72.00		
1	6" cap		3.75		
10	yds. gravel @ 2.18		21.80		
6	hr. trucking @ 3.00		18.00		
8	hr. shovel @ 6.50		52.00		
½	hr. comp. @ 5.00		2.50		
1	hr. loader @ 4.00		4.00		
	Blaster & Equipment		70.00		
	Caps & Powder		75.00		
	Bond & Insurance		150.00		
			1,016.31		


DATE \_\_\_\_\_

TOWN OF LEXINGTON — BOARD OF PUBLIC WORKS

SEWER DIVISION

Sketch of Service Here

25

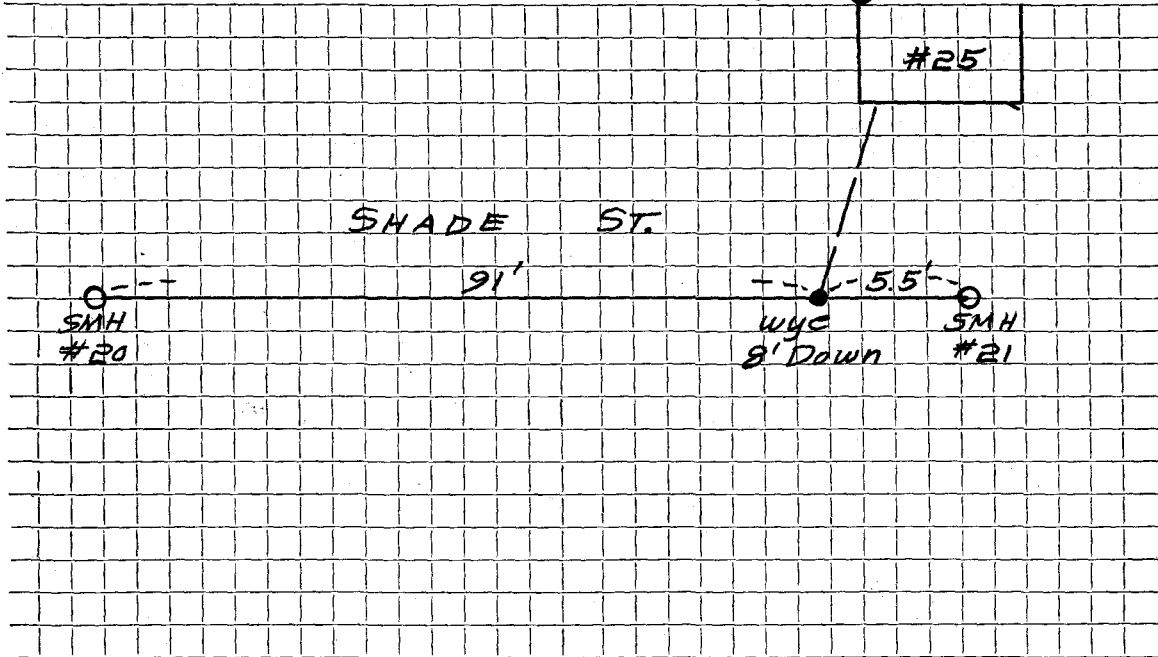

Connection made in ..... Street. Work completed .....

Remarks: .....

.....

.....