

Name Joseph Chisholm

Service No. #71

Address #28 Shade St.

Lot 13 28 Shade Street Location

Kind of Pipe

Size 6"

Size of Main 8"

~~Repair~~ ~~Renewal~~ New Service WO # 7343

Location Comm 10-1-62

Date	Material	Amount	Total	Date	Amount	
6-12-62	Labor	102.92		6-5-62	Deposit	200 00
6-13-62	"	107.02	209.94	10-1-62	Paid by WHC #58	18 69
	10% O.H.	20.99	230.93	10-1-62	Paid by WHC #69	7 46
54'	6" Transite Pipe @.78		42.12			130 58
1	90° Transite Elbow		4.09			356 73
1	11¼° Transite Bend		4.09			
7	Hrs. Town Shovel @6.50		45.50			
4	Hrs. Trucking @3.00		12.00			
18	X 3 Patch		18.00			
			356.73			


DATE _____

TOWN OF LEXINGTON — BOARD OF PUBLIC WORKS

SEWER DIVISION

Sketch of Service Here

28

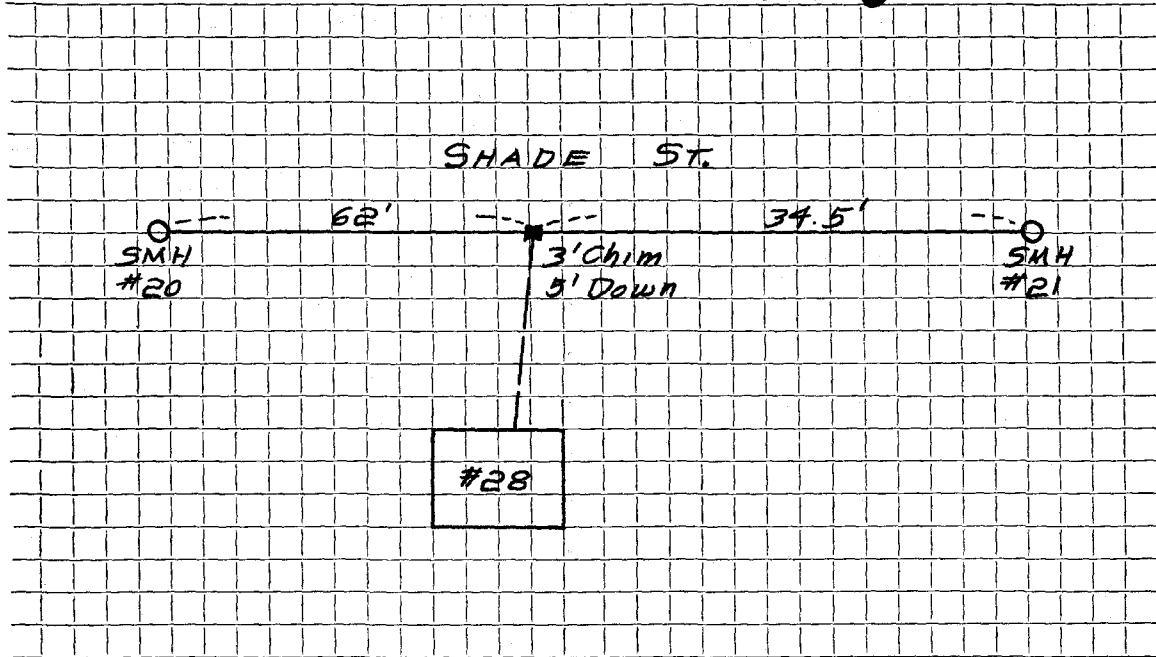

Connection made in Street. Work completed

Remarks:

.....

.....