

Name Richard Canale

Service No. 26

Address 29 Shade Street

29 Shade Street

Location

Kind of Pipe

Size 6"

Size of Main 8"

Repair—Renewal—New Service

Eagle #1843
W.O. # 9468

Location JUL 26 1971


Date	Material	Amount	Total	Date	Amount
5/10/71	Labor	103 20		4-26-71	200 00
5/21/71	"	28 54	131 74	7-24-71	14 78
	10% O.H.		13 17		214 78
	20' Transite pipe .90		18 00		
	1 22 1/2" E11		3 95		
	1 Ton cold patch		8 00		
	1 1/2 Ton Hot top 7.45		11 17		
	4 Hrs. Trucking 3.00		12 00		
	1/2 Hr. Trucking 1.50		75		
	2 Hrs. Shovel 6.50		13 00		
	1/2 Hr. Roller 2.00		1 00		
	Trailer		2 00		
			214 78		
1-12-71	115' 6" Transite pipe				
	51' 4" Cast Iron Pipe				

Bill sent 14-78

DATE _____

TOWN OF LEXINGTON — BOARD OF PUBLIC WORKS

SEWER DIVISION

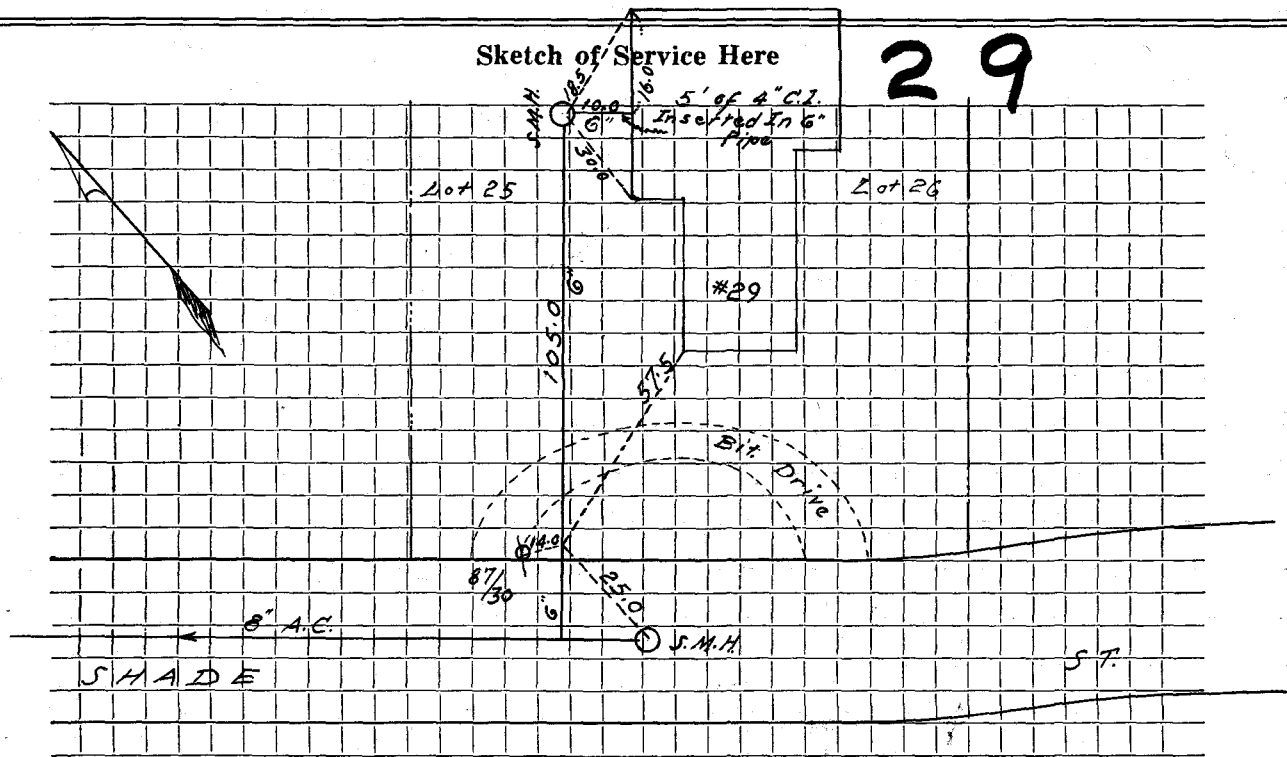

Connection made in Street. Work completed

Remarks:
.....
.....