

Name **Joseph Chisholm**

Service No. **11**

Address **34 Shade Street**

**34 Shade Street**

Location

Kind of Pipe

Size **6"**

Size of Main **8"**

~~Repair or Renewal~~ **New Service** WO #7080


Location **Can 5-28-62**

Date	Material	Amount	Total	Date	Amount
4/5/62	Labor	36.74		3-23-62	200 00
4/6/62	"	57.73	94 47	5-28-62	16 17
	10% O.H.	9 45	103 92	6-3-63	14 49
	72' 6" Transite Pipe @ .78		56 16		230 66
	3 1/2 Ton 1" Stone @ 1.50		4 88		
	2 11 1/2" Transite Bends @ 5.10		10 20		
	21 X 3 Patch		21 00		
	3 Hrs. Town Shovel @ 6.50		19 50		
	4 Hrs. Trucking @ 3.00		12 00		
	1 Hr. Trailer @ 3.00		3 00		
			<u>230 66</u>		
				Bill sent	14.49

DATE \_\_\_\_\_

TOWN OF LEXINGTON — BOARD OF PUBLIC WORKS  
SEWER DIVISION

Sketch of Service Here

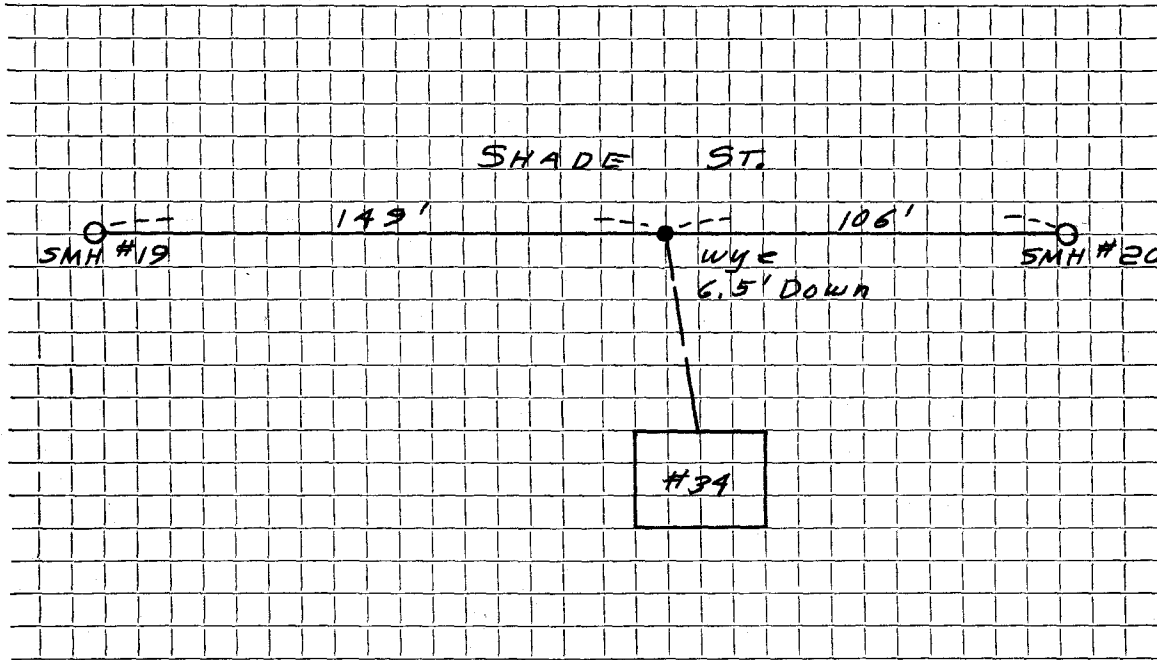

Connection made in ..... Street. Work completed .....

Remarks: .....  
.....  
.....