


DATE _____

TOWN OF LEXINGTON — BOARD OF PUBLIC WORKS
SEWER DIVISION

Sketch of Service Here

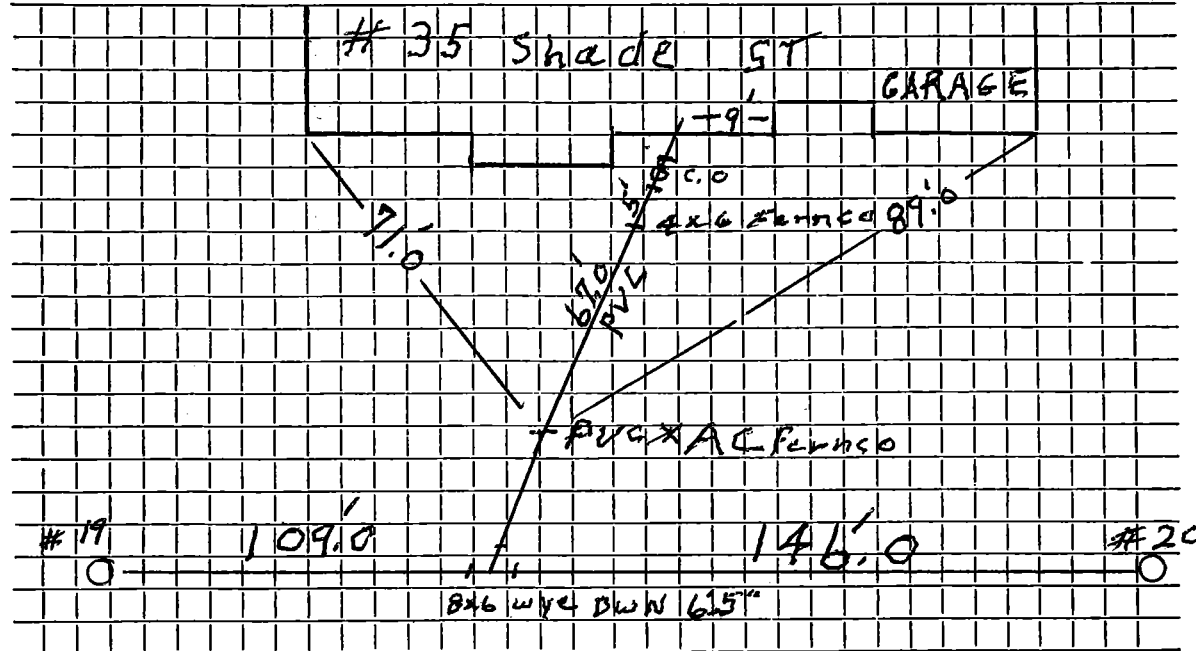

Connection made in Street. Work completed

Remarks: Clean OUT 1.0" OUT from Foundation

@ wye 22.5' + 11.2' sweep

.....