

Name Joseph Chisholm

Service No. #12

Address #40 Shade St.

40 Shade Street

Location

Kind of Pipe

Size 6"

Size of Main 8"

~~Repair~~ ~~Renew~~ - New Service WO #7081

Location Comm 6-25-62


Date	Material	Amount	Total	Date	Amount
4-6-62	Labor	26.85		3-23-62	200 00
4-9-62	"	95.11	121.96	6-25-62	7 39
	10% O.H.	12.20	134.16	7-9-62	55 62
	65' 6" Transite Pipe @78		50.70		263 01
	5 1/2 Ton 3/4" Stone @1.50		8.25		
	1 90° Transite Elbow		5.40		
	21 X 3 Patch		21.00		
	5 Hrs. Town Shovel @6.50		32.50		
	3 Hrs. Trucking @3.00		9.00		
	2 Hrs. Pumping @1.00		2.00		
			263.01		

DATE _____

TOWN OF LEXINGTON — BOARD OF PUBLIC WORKS

SEWER DIVISION

Sketch of Service Here **40**

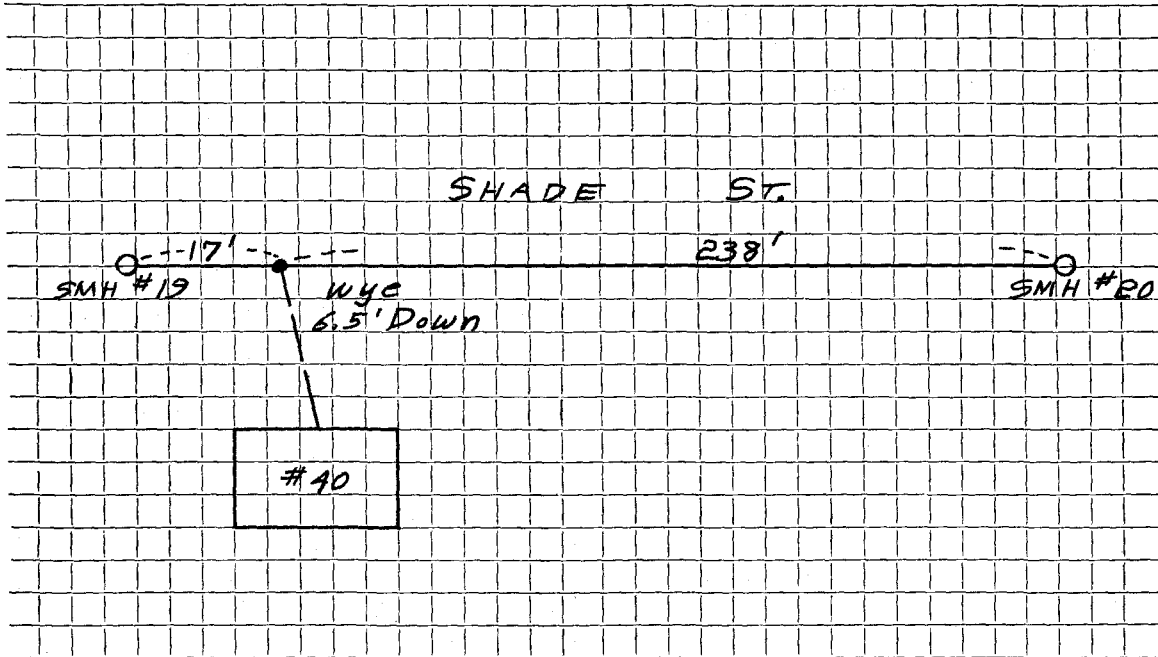

Connection made in Street. Work completed

Remarks:
.....
.....