

Service No.

Name EARL J. KYINGDAL  
Address # 41 SHADE ST.  
41 Shade Street

Location

Kind of Pipe A.C. Size 6" Size of Main 8"


Repair—Renewal—New Service w.o. #5847 PERMIT #3051 DAVE EAGLE Location DEC. 12 1977

Date	Material	Amount	Total	Date	Amount
11/2/77	LABOR 119.75			10-27-77	DEPOSIT 270 00
20'	10% OH. 11.97	131	72	12-12-77	REFUND 1 00
	6" TRANSITE PIPE @ 1.50	30 00			268 94
1	90° ELBOW	5 70			
2	TON C. PATCH @ 13.25	26 50			
3	MRS. TRUCKING @ 3.00	9 00			
4	MRS. BACKHOE @ 6.50	26 00			
	HOT TOP 15' x 4'	40 02	268 94		
11/14/77	58' - 6" AC				
	10' - 4" AC				

DATE \_\_\_\_\_

TOWN OF LEXINGTON — BOARD OF PUBLIC WORKS  
SEWER DIVISION

Sketch of Service Here **41**

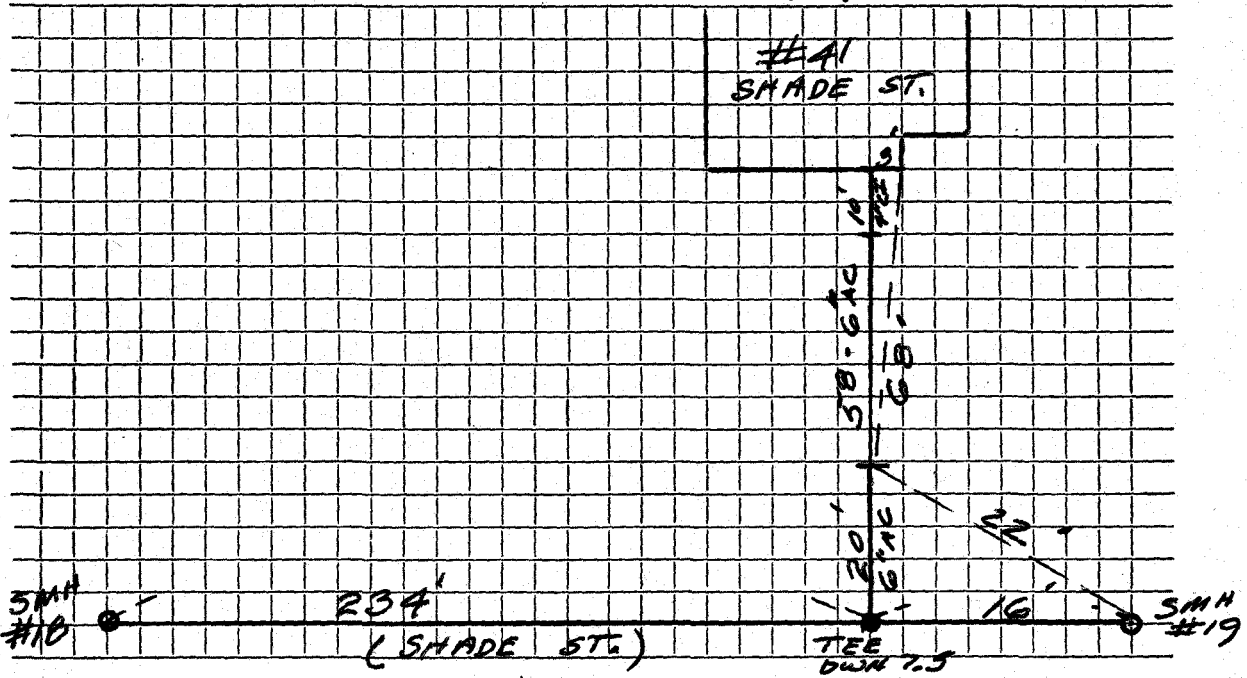

Connection made in ..... SHADE ..... Street. Work completed .....

Remarks: .....