

Name Bjorn Nordemo

Service No. 55

Address #45 Shade St.

45 Shade Street

Location

Kind of Pipe

Size 6"

Size of Main 8"

Repair—Renewal—New Service W.O. #936 Eagle #2291


Location Comm 10-53-73

Date	Material	Amount	Total	Date	Amount
6/18/73	Labor	111 49		6-15-73	Deposit 180 00
	10% O.H.	11 15	122 64	10-33-73	Paid by W.H.P. # 55 46 55
	25 6" transite pipe @	90	22 50		336 55
	1 6" elbow		6 83		
	14x6 patch		55 00	OUTSIDE - NO CHARGE	
	1 hour trucking		3 00	6/28/73	Labor 37 89
	2½ hours town shovel @	6 50	16 25		3½ hrs trucking @ 3.00 10 50
			226 22		½ hr. compressor @ 5.00 2 50
6/25/73	95' 6" Transite pipe				½ hr. loader @ 4.00 2 00
					1 hr. roller @ 2.00 2 00
					54 89

DATE \_\_\_\_\_

TOWN OF LEXINGTON — BOARD OF PUBLIC WORKS

SEWER DIVISION

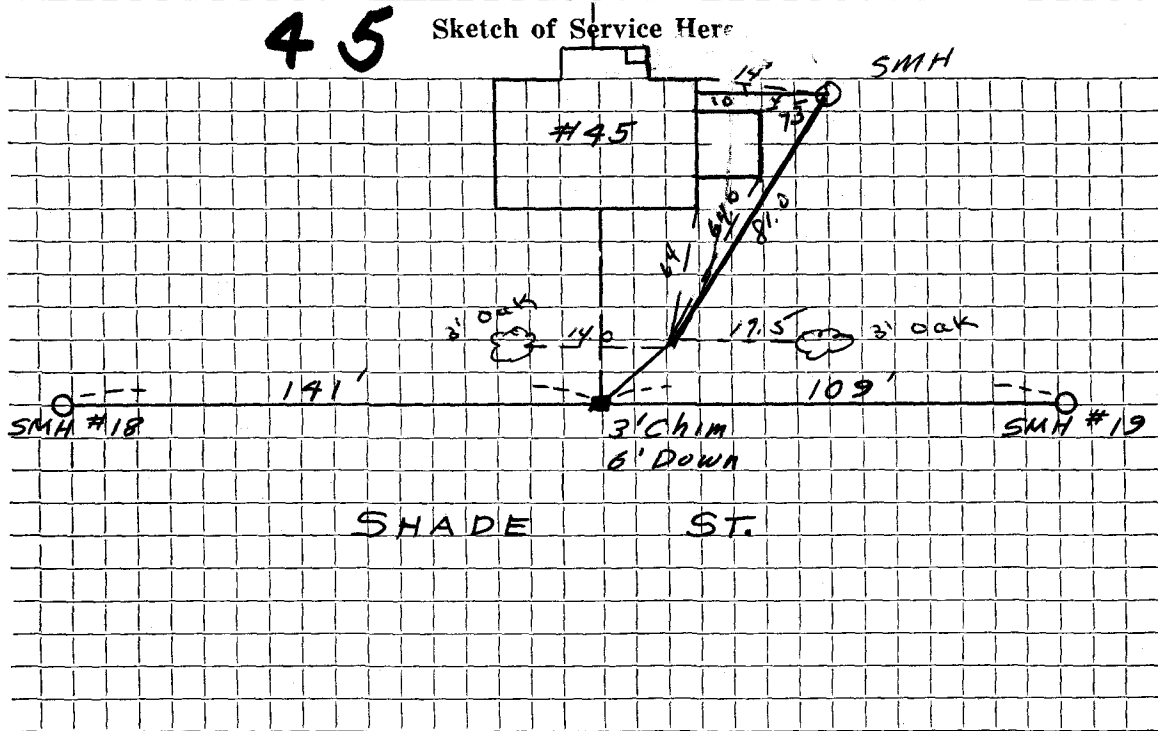

Connection made in ..... Street. Work completed .....

Remarks: .....  
.....  
.....