




DATE \_\_\_\_\_

TOWN OF LEXINGTON — BOARD OF PUBLIC WORKS

SEWER DIVISION

Sketch of Service Here

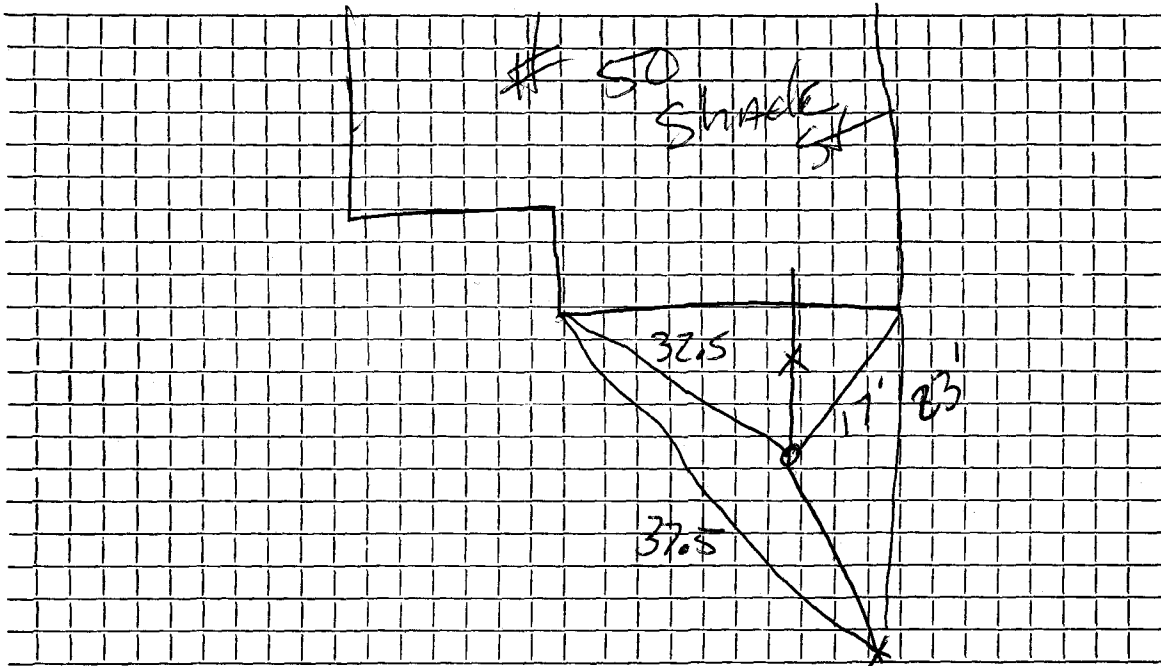

Connection made in ..... Street. Work completed .....

Remarks: ..... NEW pipe connected to existing A.C pipe in  
front yard not at property line  
SERVICE CONNECTED 18.5' up from M.H # 18