

Name Bradford Abele

Service No. 173

Address #51 Shade St.

51 Shade Street

Location

Kind of Pipe

Size 6"

Size of Main 8"

Repair—Renewal—New Service W.O.#5902 Valeri Const. 882

Location AUG 5 1968

Date	Material	Amount	Total	Date	Amount
11-29-67	Labor 68.56			11-24-67	208.60
11-30-67	" 10.51			8-3-68	29.97
11-30-67	" 8.25	87.32			170.63
	10% O.H.	8.73	96.05		
	25' 6" Transite pipe @.88		22.00		
	1 90° Transite Elbow		4.09		
	1 bag cement		1.55		
	1 doz brick		.54		
	1 ton Cold Patch		5.50		
	1 ton Hot top		5.80		
	3½ hrs. Trucking @3.00		10.50		
	2 hrs. Town Shovel @6.50		13.00		
	1½ hr. Compressor @5.00		7.50		
	½ hr. Roller & trailer		3.50		
12-1-67	43' 6" Transite pipe		170.03		
	10' 4" Cast Iron pipe				


DATE _____

TOWN OF LEXINGTON — BOARD OF PUBLIC WORKS

SEWER DIVISION

Sketch of Service Here

51

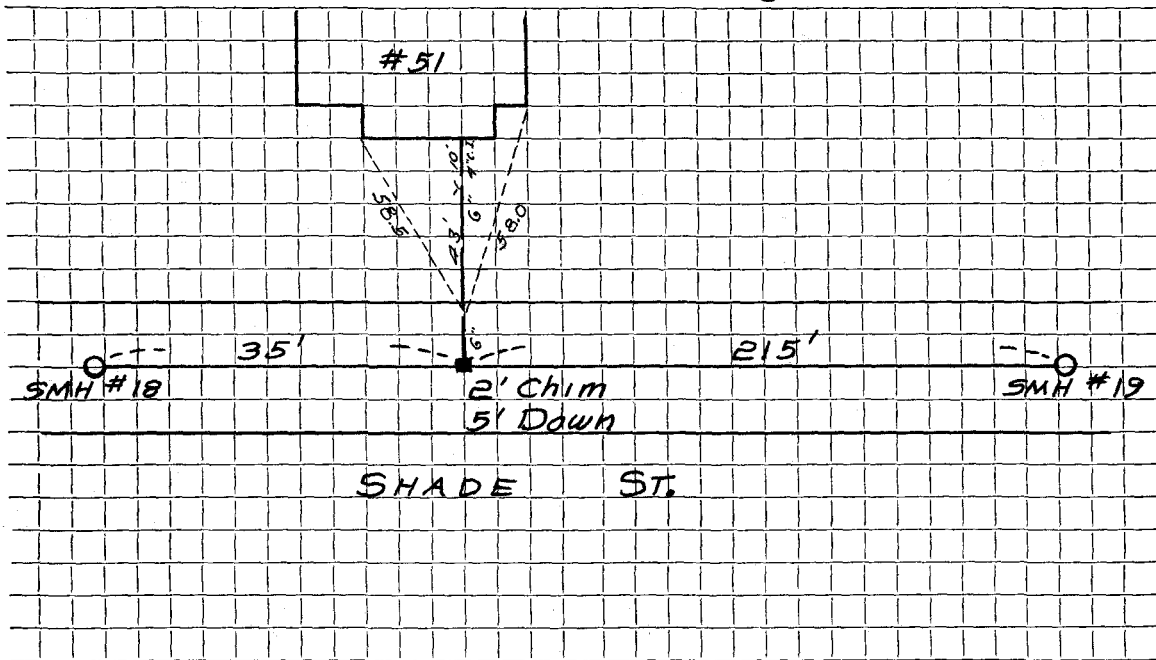

Connection made in Street. Work completed

Remarks:
.....
.....