

Name David Mittelstadt

Service No. 49

Address 54 Shade Street

54 Shade Street

Location

AUG 8 1977

Kind of Pipe

Size 6"

Size of Main 8"

~~XXXXXXXXXX~~ New Service WO #4681 Eagle #2857


Location

Date	Material	Amount	Total	Date	Amount
7/15/76	labor 121.60			7-9-76	Deposit 350 00
7/22/76	labor 33.53	155. 13		8-16-76	Refund 34 25
	10%OH	15. 51	170. 64		315 75
	2 6" - 5 ft. length transite pipe @	1.56	3. 12		
	1 6" - 11 1/2 collar		6. 76		
	Patch 9 X 15		90. 00		
	1 6" cap		3. 75		
	1 6" elbow		5. 48		
	2 1/2 hr. truck @ 3.00		7. 50		
	1 hr. comp.		5. 00		
	1 hr. loader		4. 00		
	3 hr. shovle @ 6.50		19. 50		
			315. 75		
7/19/76	37' 6" Transite Pipe				
	10' 4" Cast Iron				

DATE \_\_\_\_\_

TOWN OF LEXINGTON — BOARD OF PUBLIC WORKS  
SEWER DIVISION

Sketch of Service Here **54**

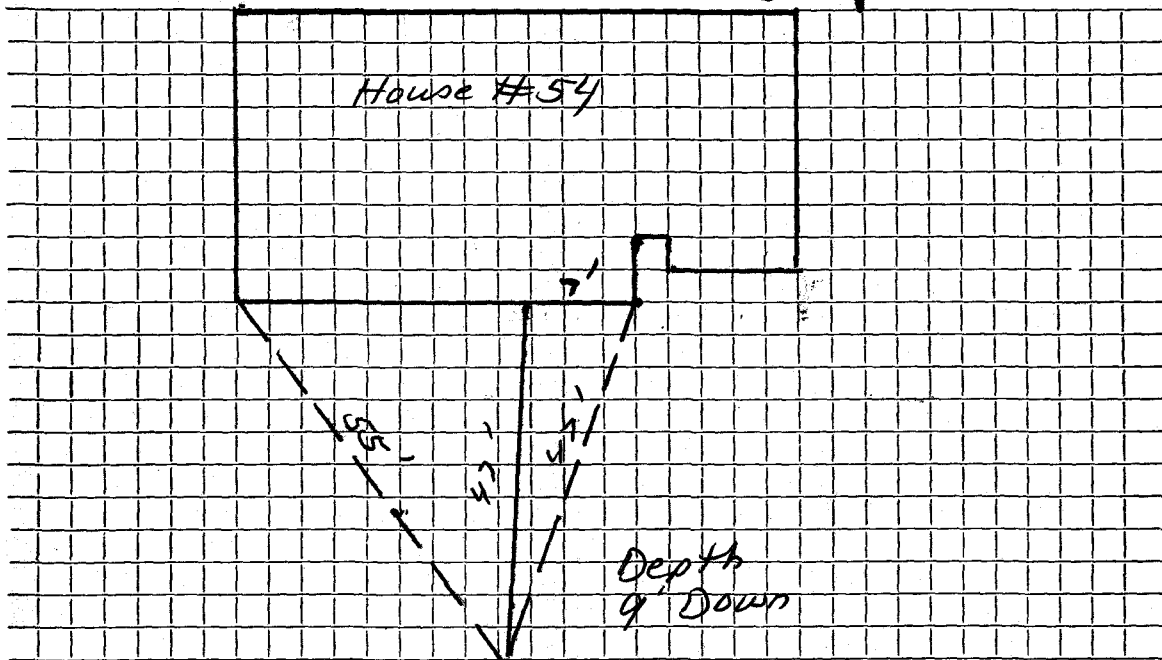

Connection made in ..... Street. Work completed .....

Remarks: .....  
.....  
.....