

Name William Watson

Service No. ' 60

Address #55 Shade St.

55 Shade Street

Location

Kind of Pipe

Size 6"

Size of Main 8"

~~Repair Renewal~~ New Service

W # 7243

Location Comm 7-16-62

Date	Material	Amount	Total	Date	Amount
5/31/62	Labor 91.29			5-16-62	Deposit 250.00
6/4/62	" 32.81	124 10		7-16-62	Retard 2.08
	10% O.H.	12 41	136 51		247.92
60'	6" Transite Pipe @ .78		46 80		
	1 90° Transite Elbow		5 40		
	1 22½° Transite Elbow		6 21		
	4 Hrs. Town Shovel @ 6.50		26 00		
	3 Hrs. Trucking @ 3.00		9 00		
	18 X 3 Patch		18 00		
7-15-76			247.92		
	1 6"x6" Transite Nipple			10/14/71	Sludge
	1 6"-90° Elbow			11-25-75	Roots
	1 6" Adapter				


DATE _____

TOWN OF LEXINGTON — BOARD OF PUBLIC WORKS

SEWER DIVISION

Sketch of Service Here

55

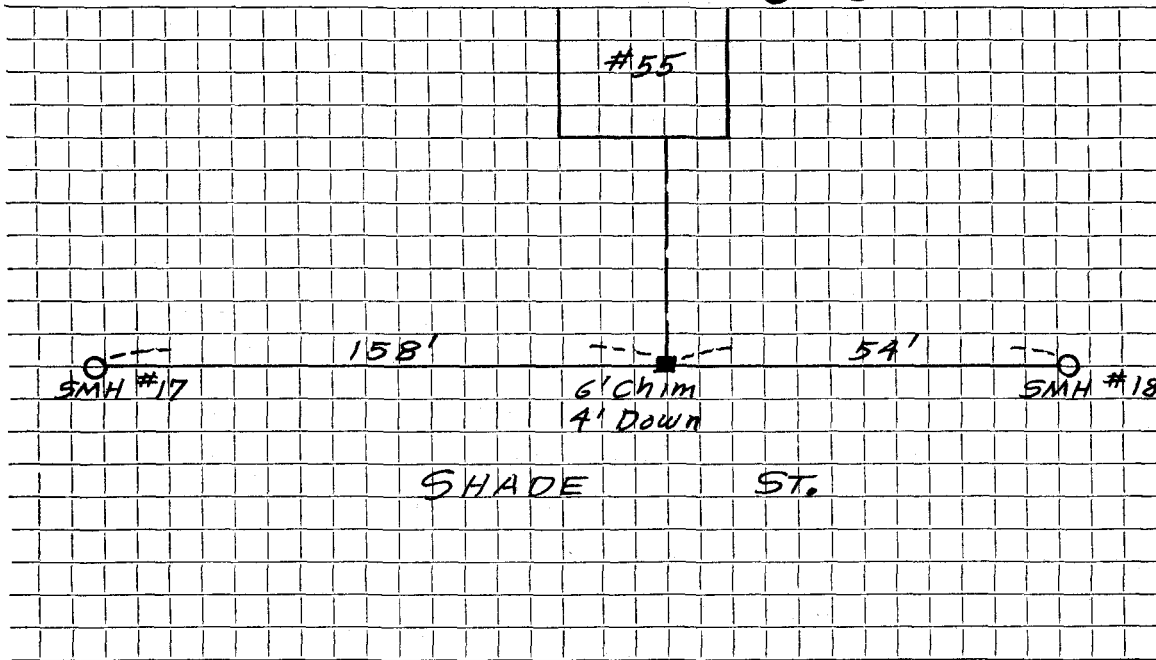

Connection made in Street. Work completed

Remarks:
.....
.....