

Name James Lambie

Service No. 226

Address #56 Shade St.

56 Shade Street

Location

Kind of Pipe

Size 6"

Size of Main 8"

Repair—Renewal—New Service

WC# 7777

Location


Comm 5-27-63

| Date | Material | Amount | Total | Date | Amount |
|---------|----------------------------|--------|--------|----------|----------------|
| 4/15/63 | Labor 89.90 | | | 12-17-62 | Deposit 250.00 |
| 4/16/63 | " 32 70 | 122 60 | | 5-27-63 | Refund 14.40 |
| | 10% O.H. | 12 26 | 134 86 | | 235 60 |
| | 50' 6" Transite Pipe @ .82 | | 41 00 | | |
| | 1 90° Transite Elbow | | 4 09 | | |
| | 1 6" Service Saddle | | 5 65 | | |
| | 4 Hrs. Town Shovel @ 6.50 | | 26 00 | | |
| | 4 Hrs. Trucking @ 3.00 | | 12 00 | | |
| | 12 X 3 Patch | | 12 00 | | |
| | | | 235 60 | | |

DATE _____

TOWN OF LEXINGTON — BOARD OF PUBLIC WORKS
SEWER DIVISION

Sketch of Service Here **56**

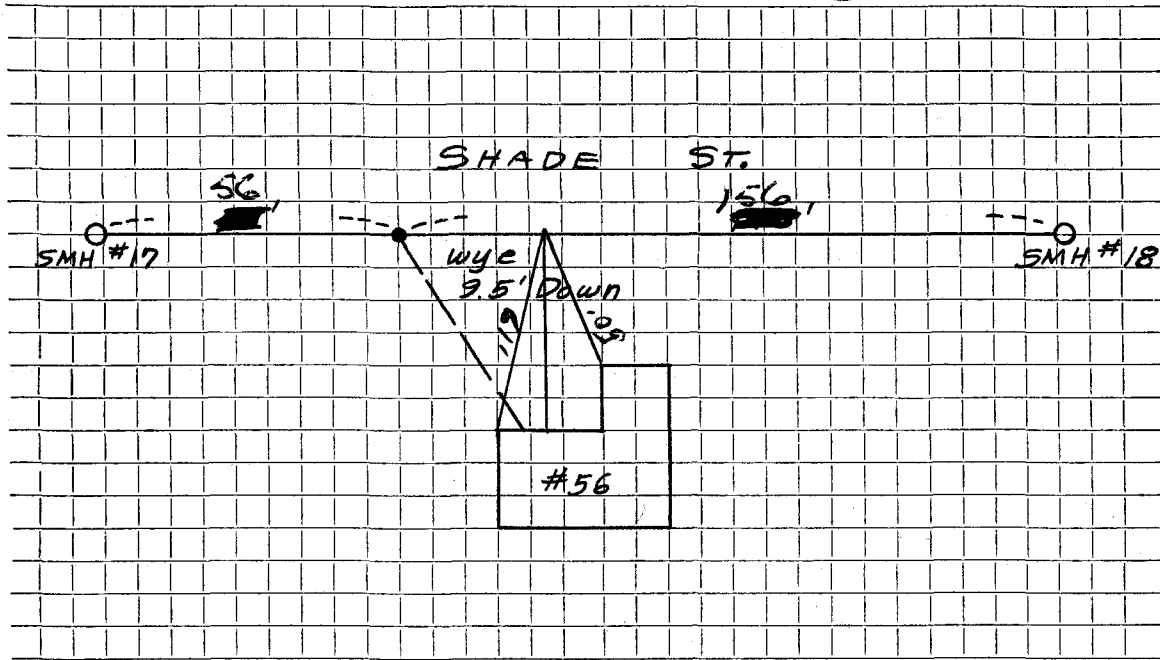

Connection made in Street. Work completed

Remarks:
.....
.....