


DATE _____

TOWN OF LEXINGTON — BOARD OF PUBLIC WORKS

SEWER DIVISION

Sketch of Service Here

57

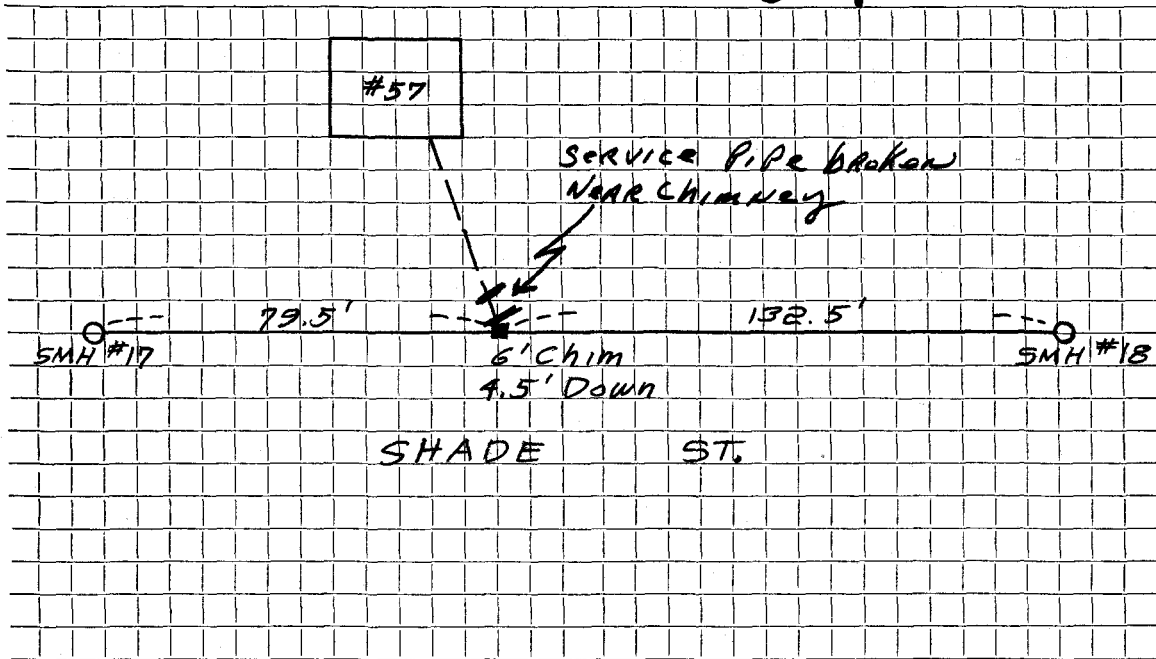

Connection made in Street. Work completed

Remarks: PIPE BROKEN AND BROKEN REPAIR MADE 4/2/80
2 FERRO ADAPTERS + 5' NIPPLE