

Name George Knox

Service No. #33

Address #63 Shade St.

63 Shade Street

Location

Kind of Pipe

Size 6"

Size of Main 8"

~~Repair~~ ~~Renewal~~ New Service WO #7175

Location Comm 6-25-62


Date	Material	Amount	Total	Date	Amount
4-30-62	Labor	65.48		4-23-62	Deposit 300.00
	10% O.H.	6.55	72.03	6-25-62	Refund 134.55
	64' 6" Transite Pipe @78		49.92		165.45
	1 11 1/4" Transite Bend		5.10		
	1 90° Transite Elbow		5.40		
	2 Hrs. Town Shovel @6.50		13.00		
	2 Hrs. Trucking @3.00		6.00		
	14 X 3 Patch		14.00		
			165.45		

DATE \_\_\_\_\_

TOWN OF LEXINGTON — BOARD OF PUBLIC WORKS

SEWER DIVISION

Sketch of Service Here **63**

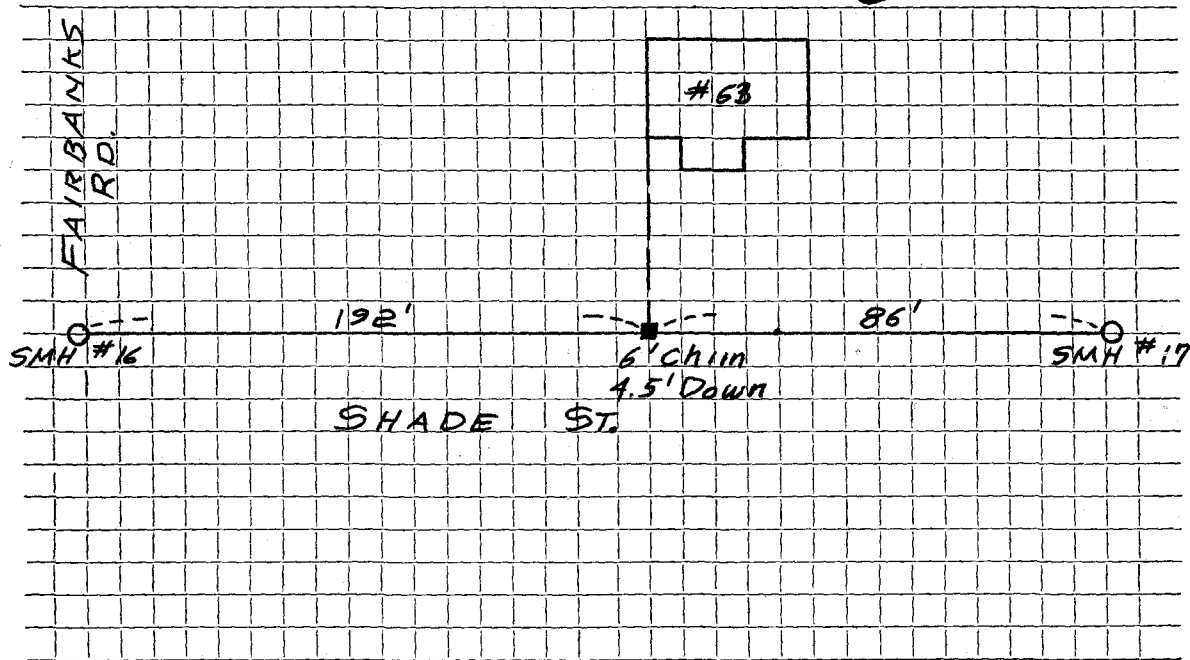

Connection made in ..... Street. Work completed .....

Remarks: .....  
.....  
.....