

Name Daniel A. Black

Service No. 41

Address #64 Shade St.

64 Shade Street

Location

Kind of Pipe

Size 6"

Size of Main 8"

~~Water Service~~ - New Service

WO# 7219

Location Comm 7-16-62

| Date    | Material                   | Amount | Total  | Date    | Amount         |
|---------|----------------------------|--------|--------|---------|----------------|
| 5/25/62 | Labor 74.55                |        |        | 5-7-62  | Deposit 200 00 |
| 5/29/62 | " 21.30                    | 95 85  |        | 5-16-62 | Refund 2 10    |
|         | 10% O.H.                   | 9 59   | 105 44 |         | 197 90         |
|         | 52' 6" Transite Pipe @ .78 |        | 40 56  |         |                |
|         | 1 90° Transite Elbow       |        | 5 40   |         |                |
|         | 3 Hrs. Town Shovel @ 6.50  |        | 19 50  |         |                |
|         | 3 Hrs. Trucking @ 3.00     |        | 9 00   |         |                |
|         | 18 X 3 Patch               |        | 18 00  |         |                |
|         |                            |        | 197 90 |         |                |


DATE \_\_\_\_\_

TOWN OF LEXINGTON — BOARD OF PUBLIC WORKS

SEWER DIVISION

Sketch of Service Here

**64**

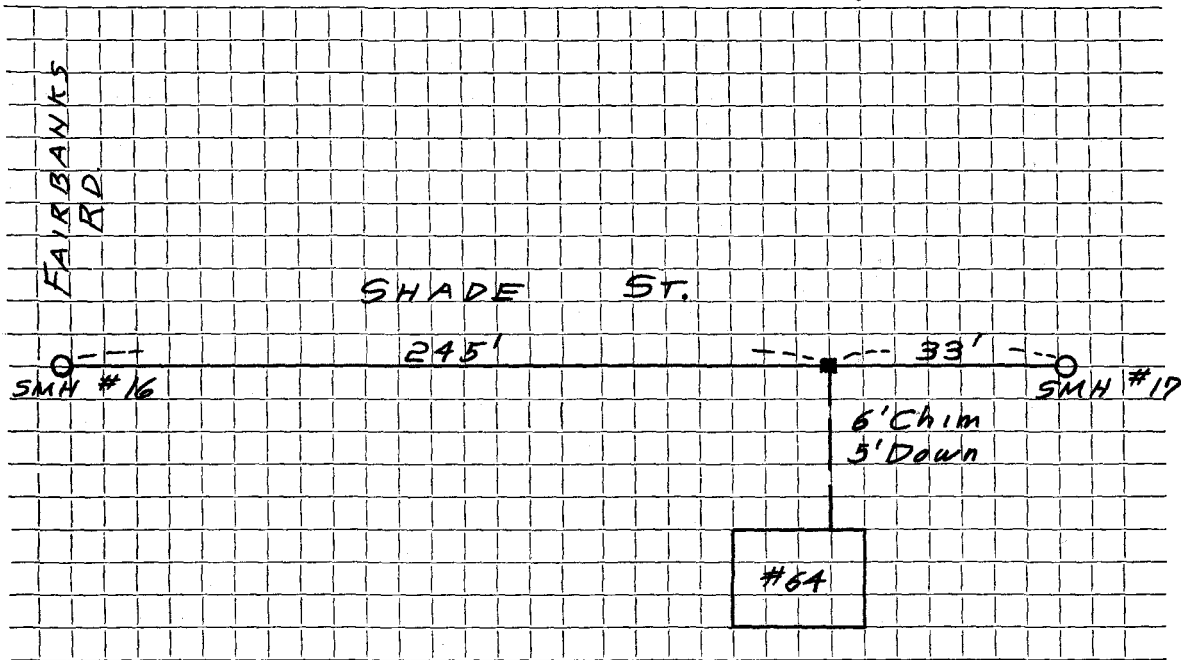

Connection made in ..... Street. Work completed .....

Remarks: .....  
.....  
.....