

Name Allen Shepp

Service No. 95

Address 68 Shade Street

68 Shade Street

Location

Kind of Pipe

Size 6"

Size of Main 8"

~~REPAIR~~ New Service Suburbanite Cesspool Permit #387 W.O.#659

Location MAR 14 1966

Date	Material	Amount	Total	Date	Amount
7-21-65	Labor	72.00		7-19-65	Deposit 135.00
7-22-65	Labor	9.00	81.00	5-11-66	Paid 43.22
	10% O.H.	8.10	89.10		168.22
	20' 6" Transtite pipe @ .82		16.40		
	1 90° Elbow		4.09		
	1 8 x 6 cast iron saddle		5.25		
	3' 6" Transite chimney @ .82		2.46		
	1/2 Bag cement @ 1.50		.75		
	10 x 3 Patch		10.00		
	2 Hrs. Town Truck @ 3.00		6.00		
	5 Hrs. Tractor @ 6.50		32.50		
	1/3 Hr. Compressor @ 5.00		1.67		
			168.22		
7-26-65	23' 6" Transite pipe				


Bill sent 43.22

DATE \_\_\_\_\_

TOWN OF LEXINGTON — BOARD OF PUBLIC WORKS

SEWER DIVISION

Sketch of Service Here **68**

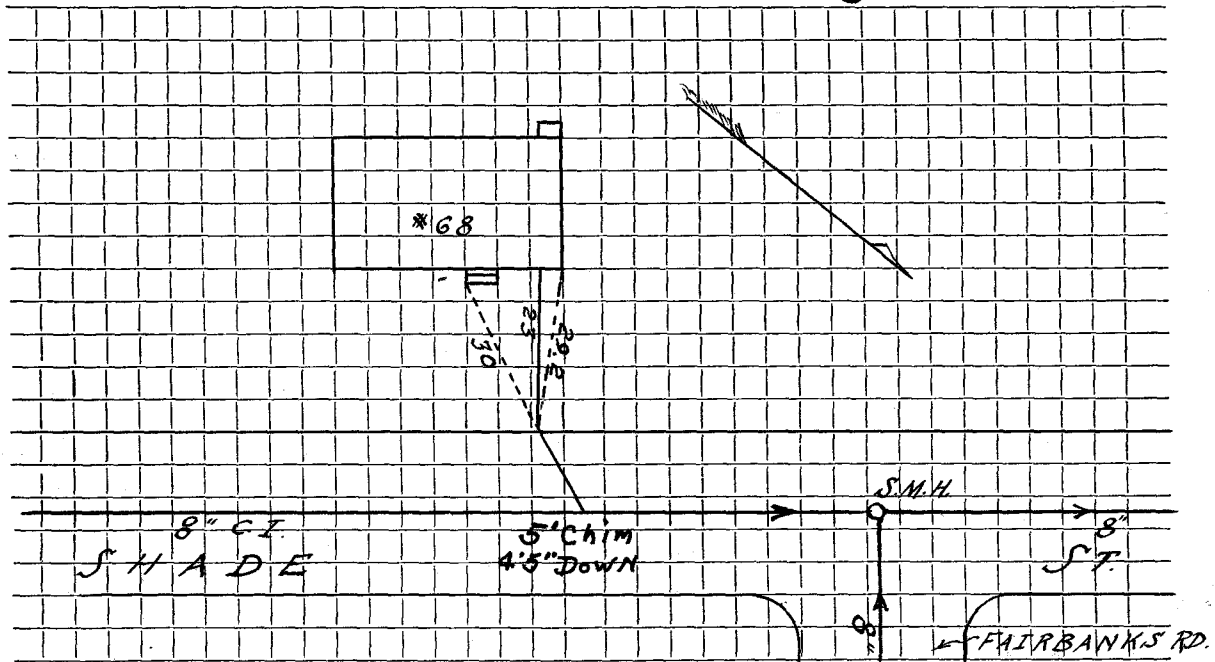

Connection made in ..... Street. Work completed .....

Remarks: .....  
.....  
.....