

Name

Service No.

Address #74 B Shade St.

74 B Shade Street

Location

Kind of Pipe

Size 6"

Size of Main 8"

Repair—Renewal—New Service


Location

Date		Material	Amount		Total		Date		Amount	

DATE _____

TOWN OF LEXINGTON — BOARD OF PUBLIC WORKS

SEWER DIVISION

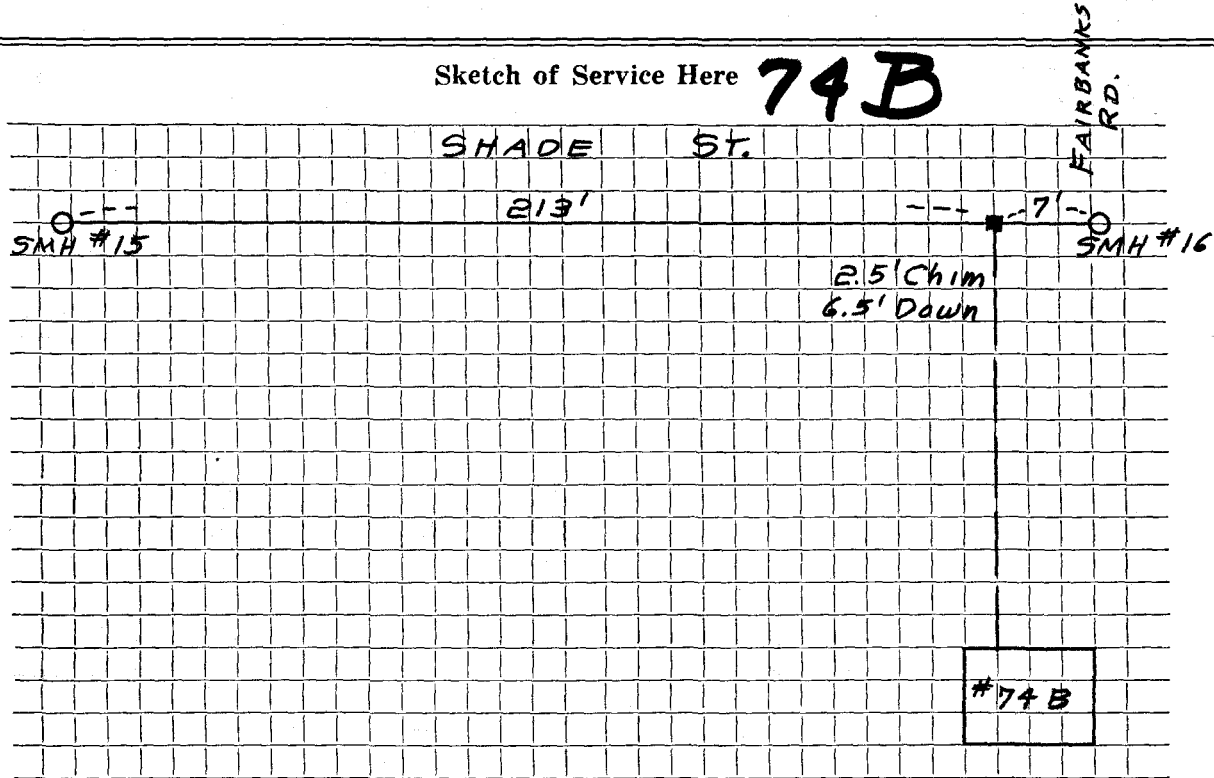

Connection made in Street. Work completed

Remarks:
.....
.....