


Date: 3/4/24

TOWN OF LEXINGTON - BOARD OF PUBLIC WORKS
SEWER DIVISION

SKETCH OF SERVICE HERE
74 Shade St.

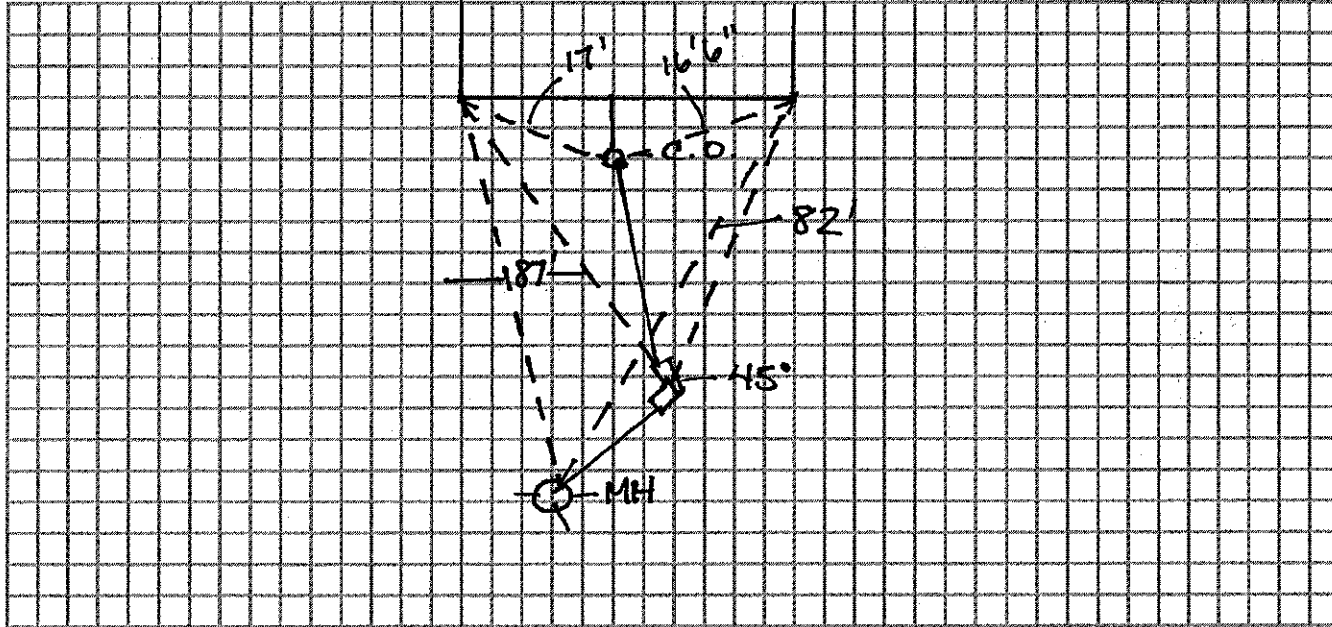

Connection made in: _____ Street. _____ Work completed: _____

Remarks: Installed by SADC