


DATE _____

TOWN OF LEXINGTON — BOARD OF PUBLIC WORKS
SEWER DIVISION

Sketch of Service Here **78**

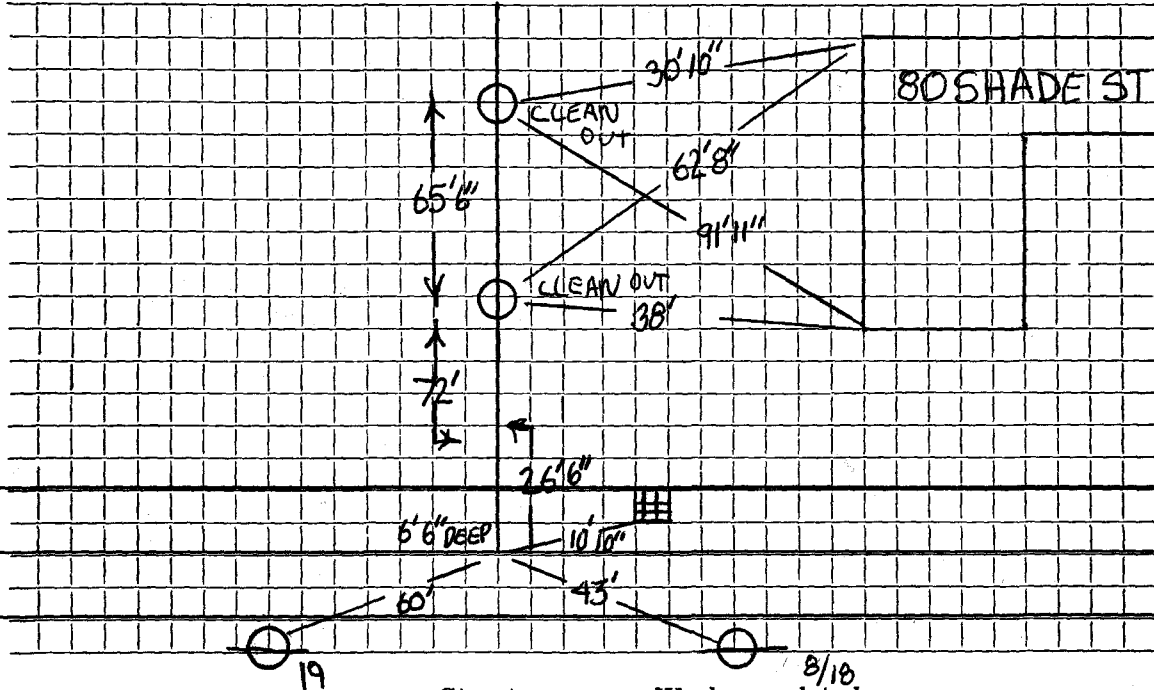

Connection made in Street. Work completed 8/18

Remarks:

.....

.....