


DATE _____

TOWN OF LEXINGTON — BOARD OF PUBLIC WORKS

SEWER DIVISION

80 Sketch of Service Here

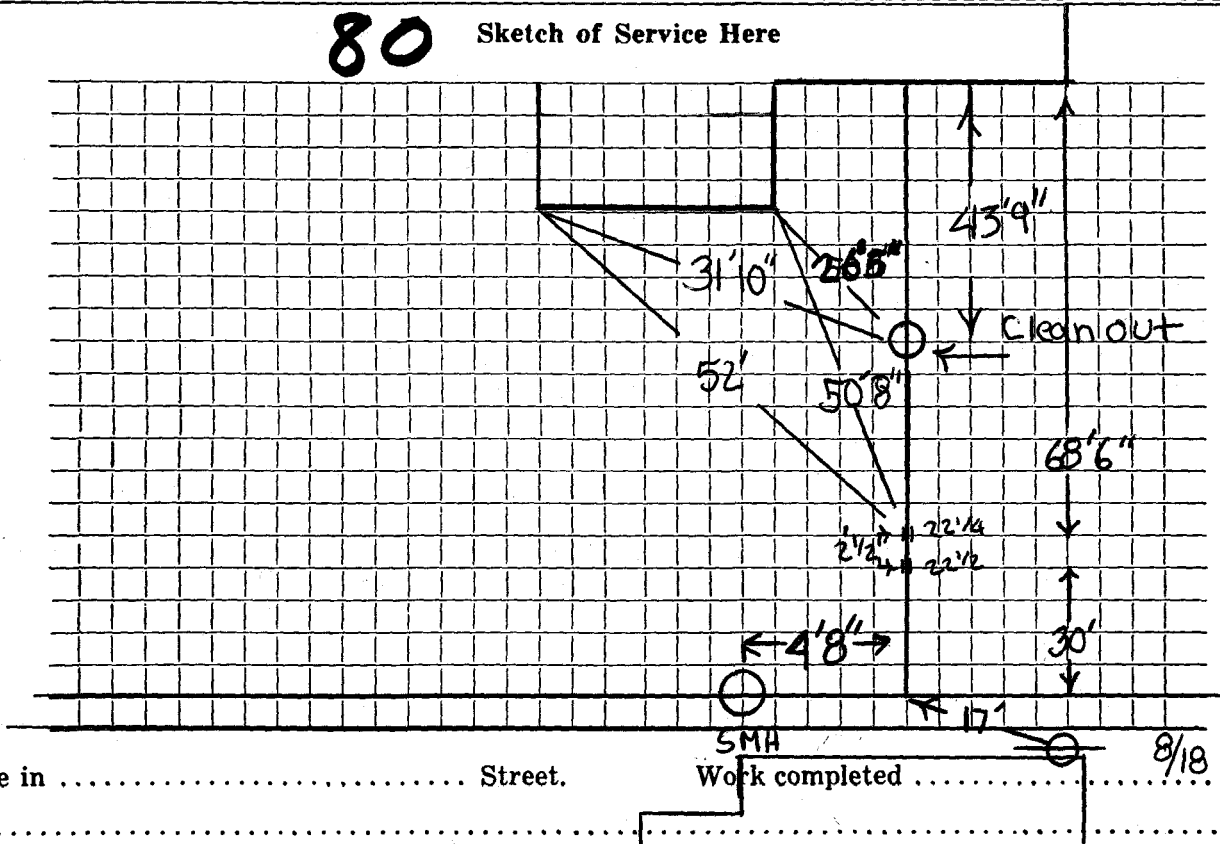

Connection made in Street. Work completed 8/18

Remarks:

.....