




DATE MARCH 20, 1997

TOWN OF LEXINGTON — BOARD OF PUBLIC WORKS

SEWER DIVISION

Sketch of Service Here

81

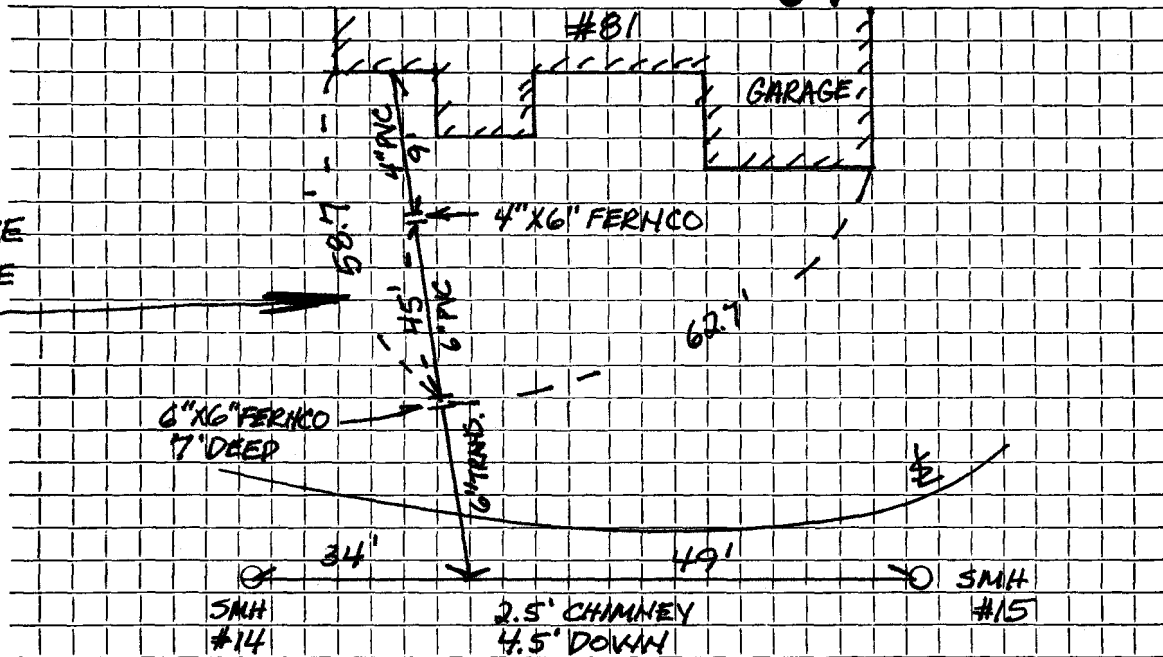

\* WATER SERVICE  
LOCATED IN SAME  
TRENCH; 18"  
ABOVE SEWER.

Connection made in SPRING STREET Street. Work completed by MVF CONTRACTORS

Remarks: TEARDOWN → TIED INTO 6" TRANSITE Original Service 9-7-67